





REVISED
DRAWING

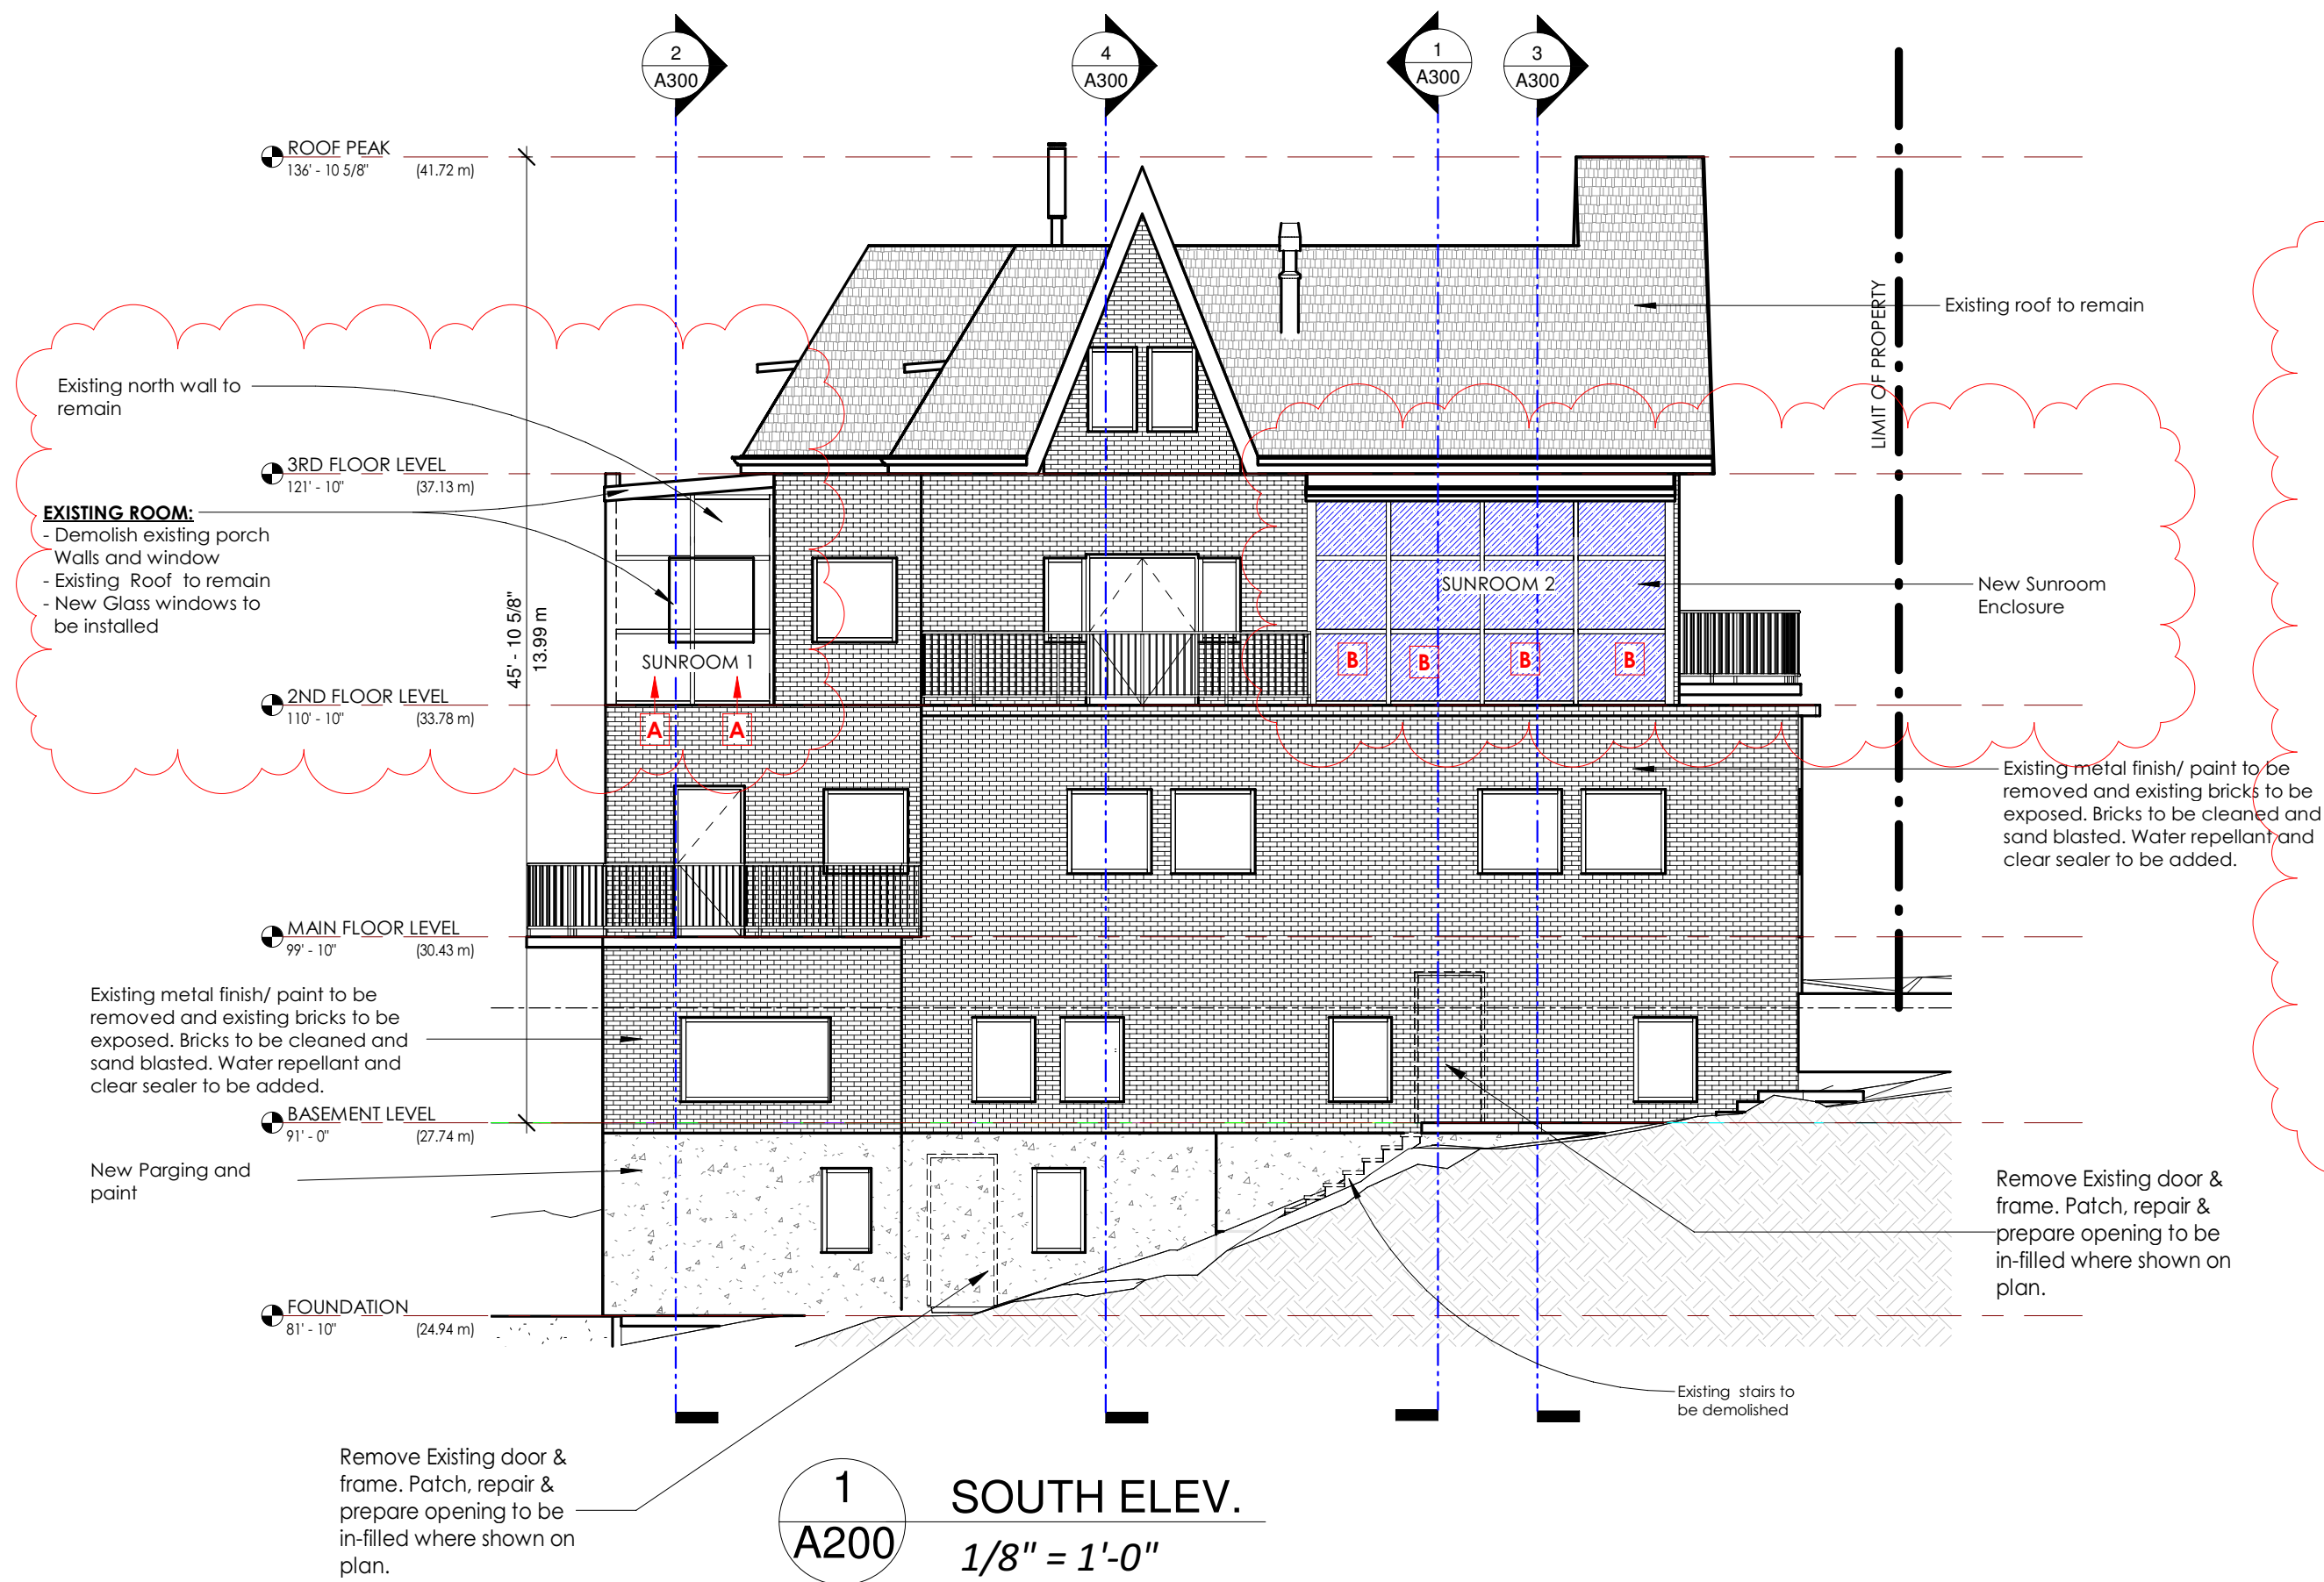

SUNROOM DOOR & WINDOW SCHEDULE:

- 1 EXISTING NORTH WALL TO REMAIN
- 2 NEW DOUBLE GLASS DOOR WITH SIDELIGHTS
- 3 NEW GLASS DOOR
- 4 NEW DOOR TO SUITE EXISTING OPENING
- A STANDARD GLASS PANELS
- B POLYCARBONATE PANELS (SEE SPECIFICATIONS)

NOTE:
SEE STRUCTURAL DRAWINGS FOR SUNROOM ENCLOSURE DETAILS

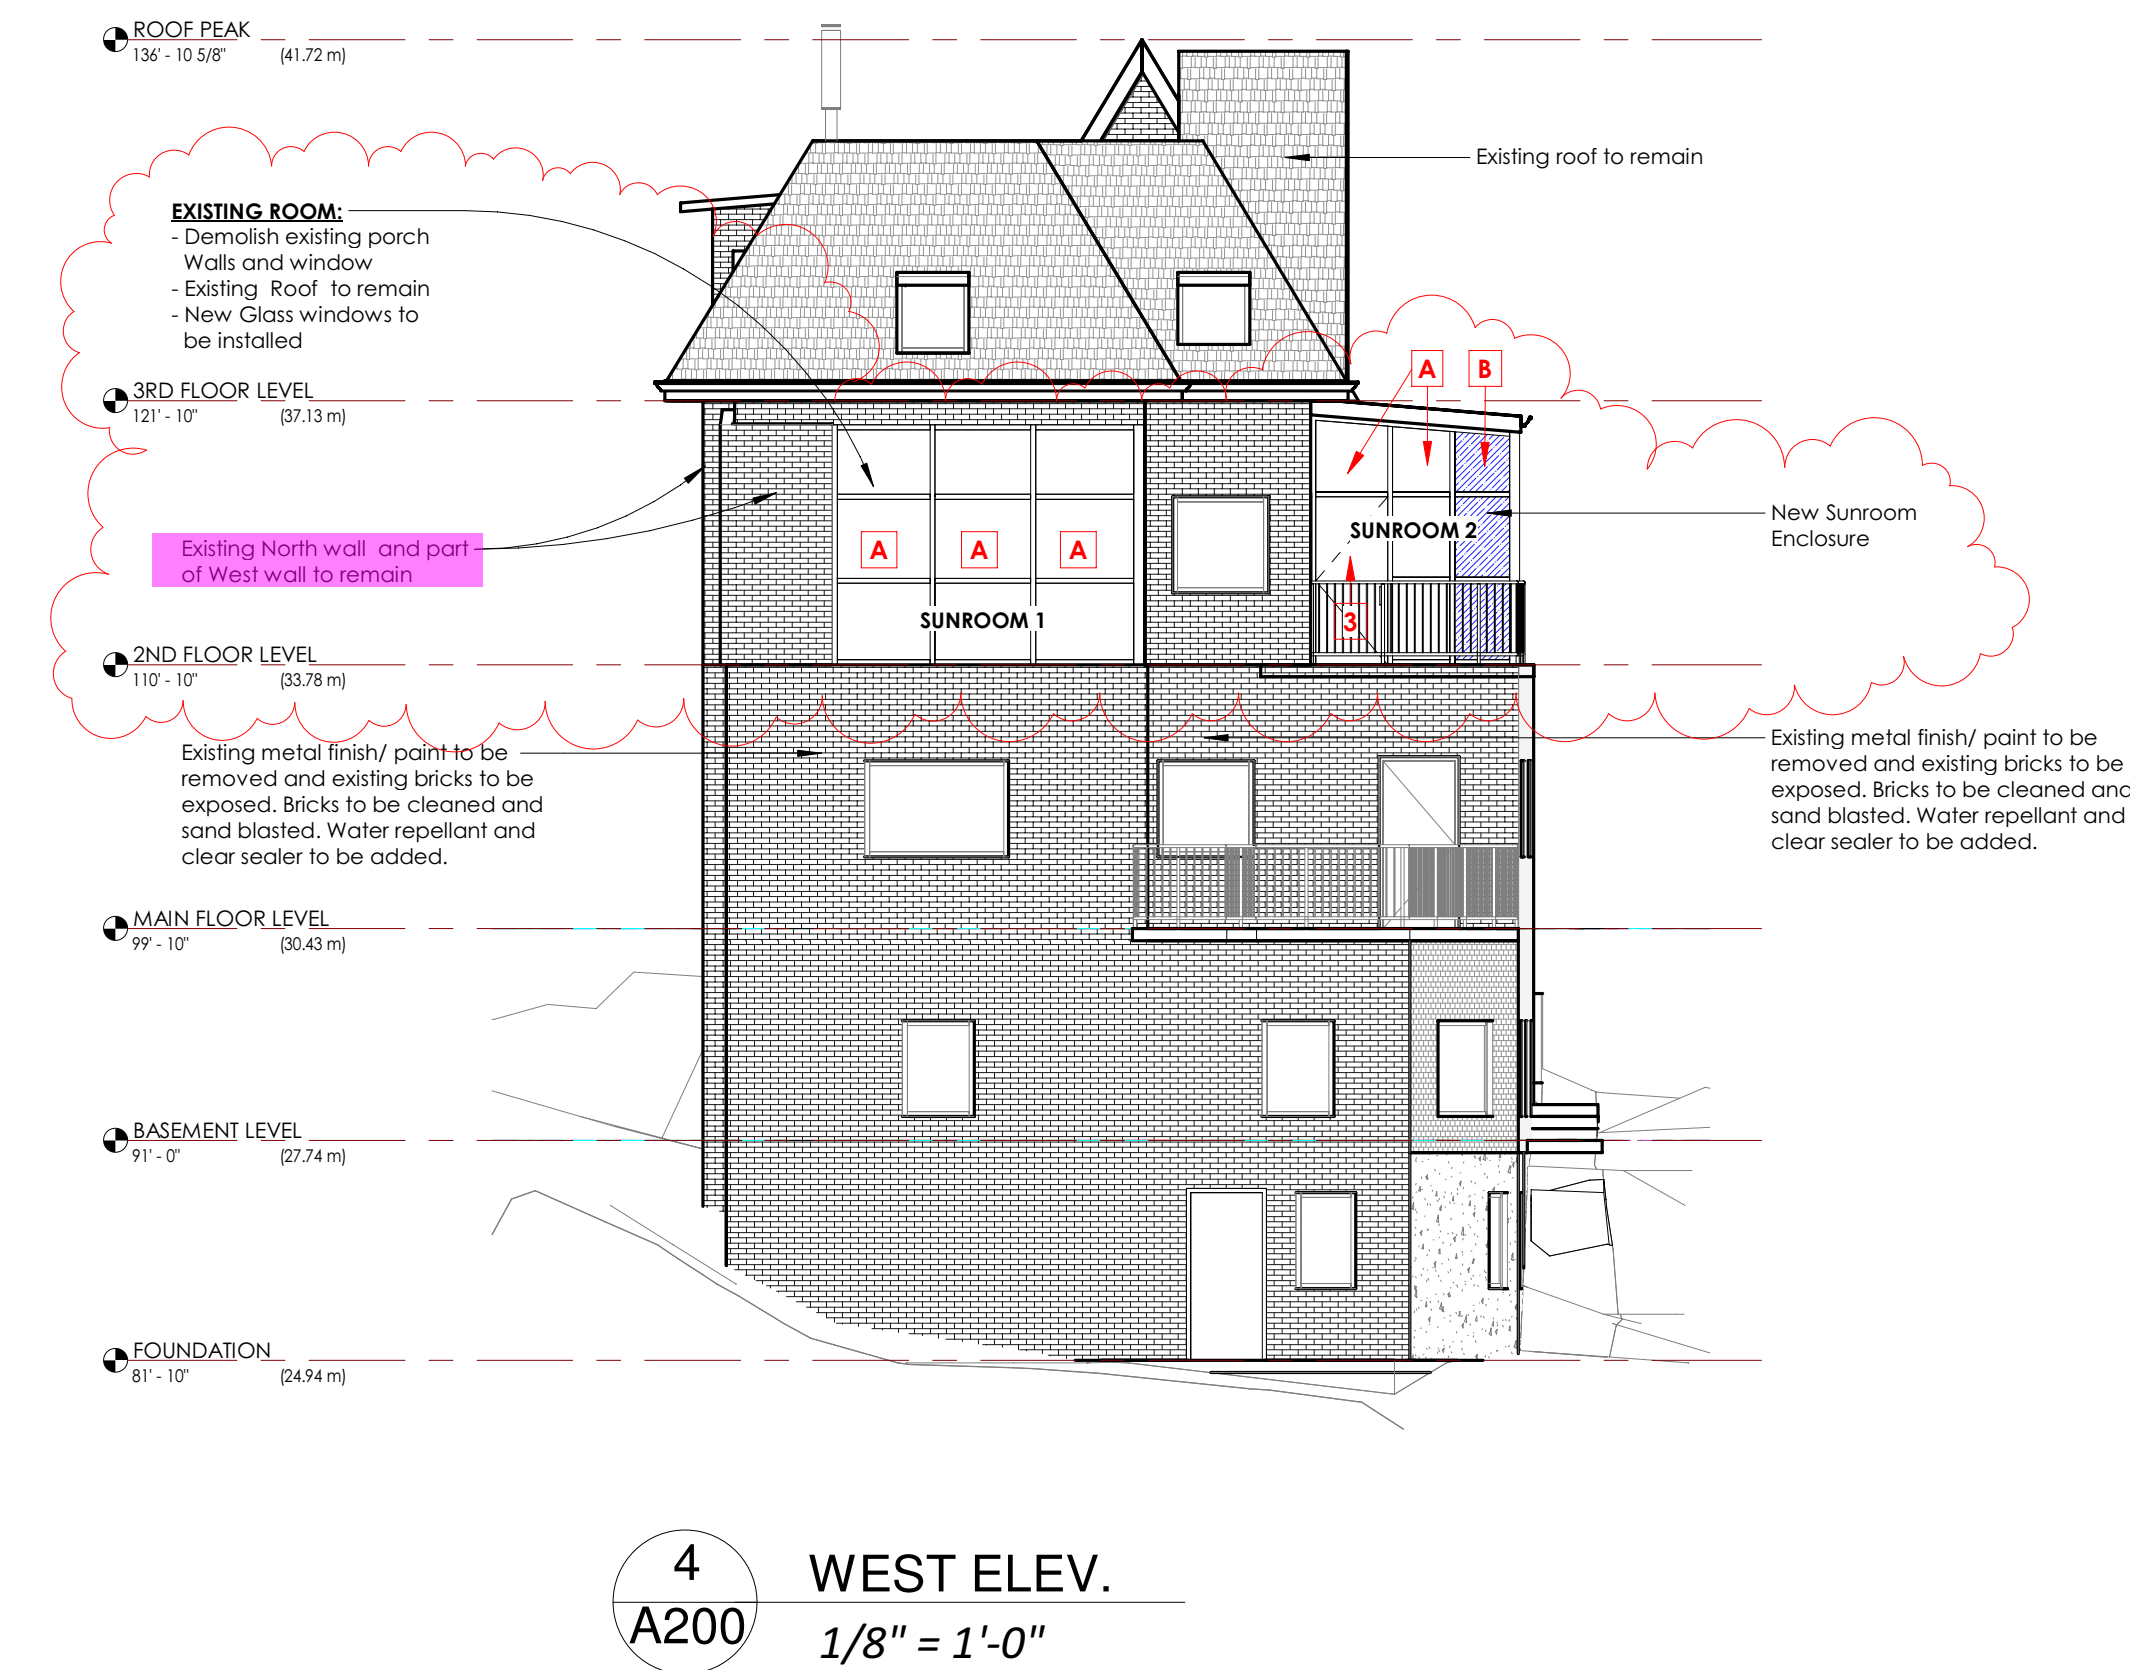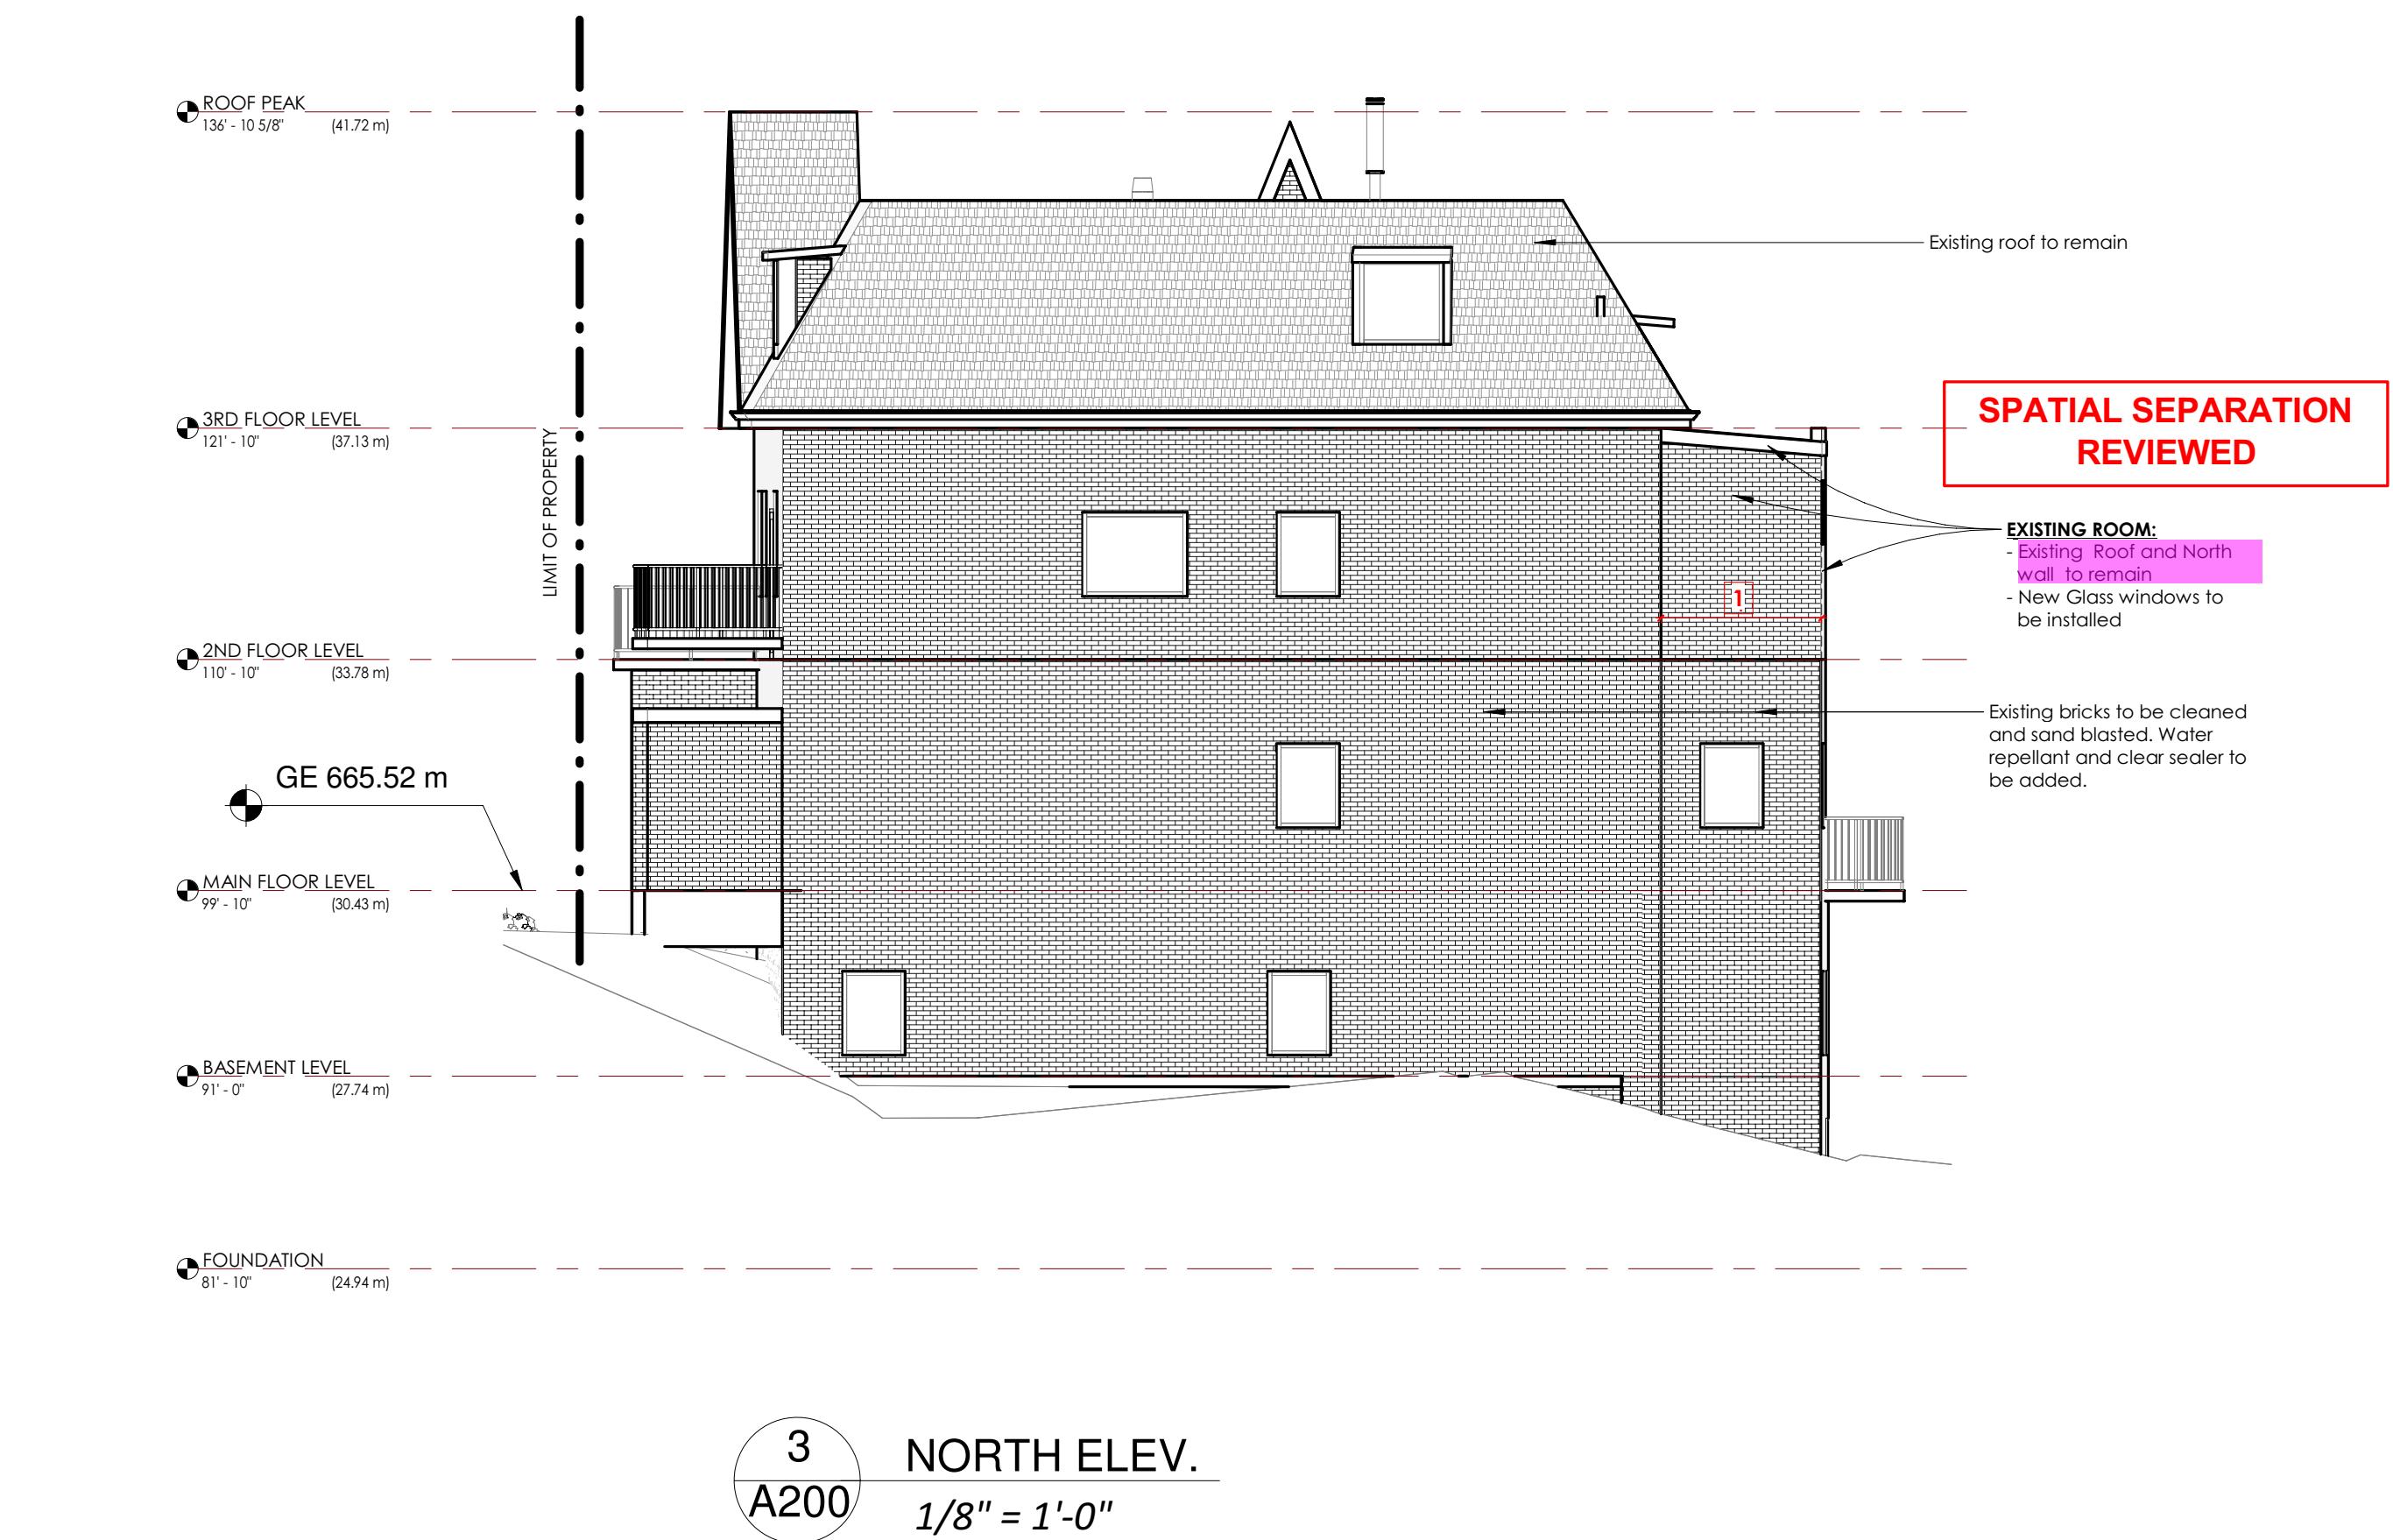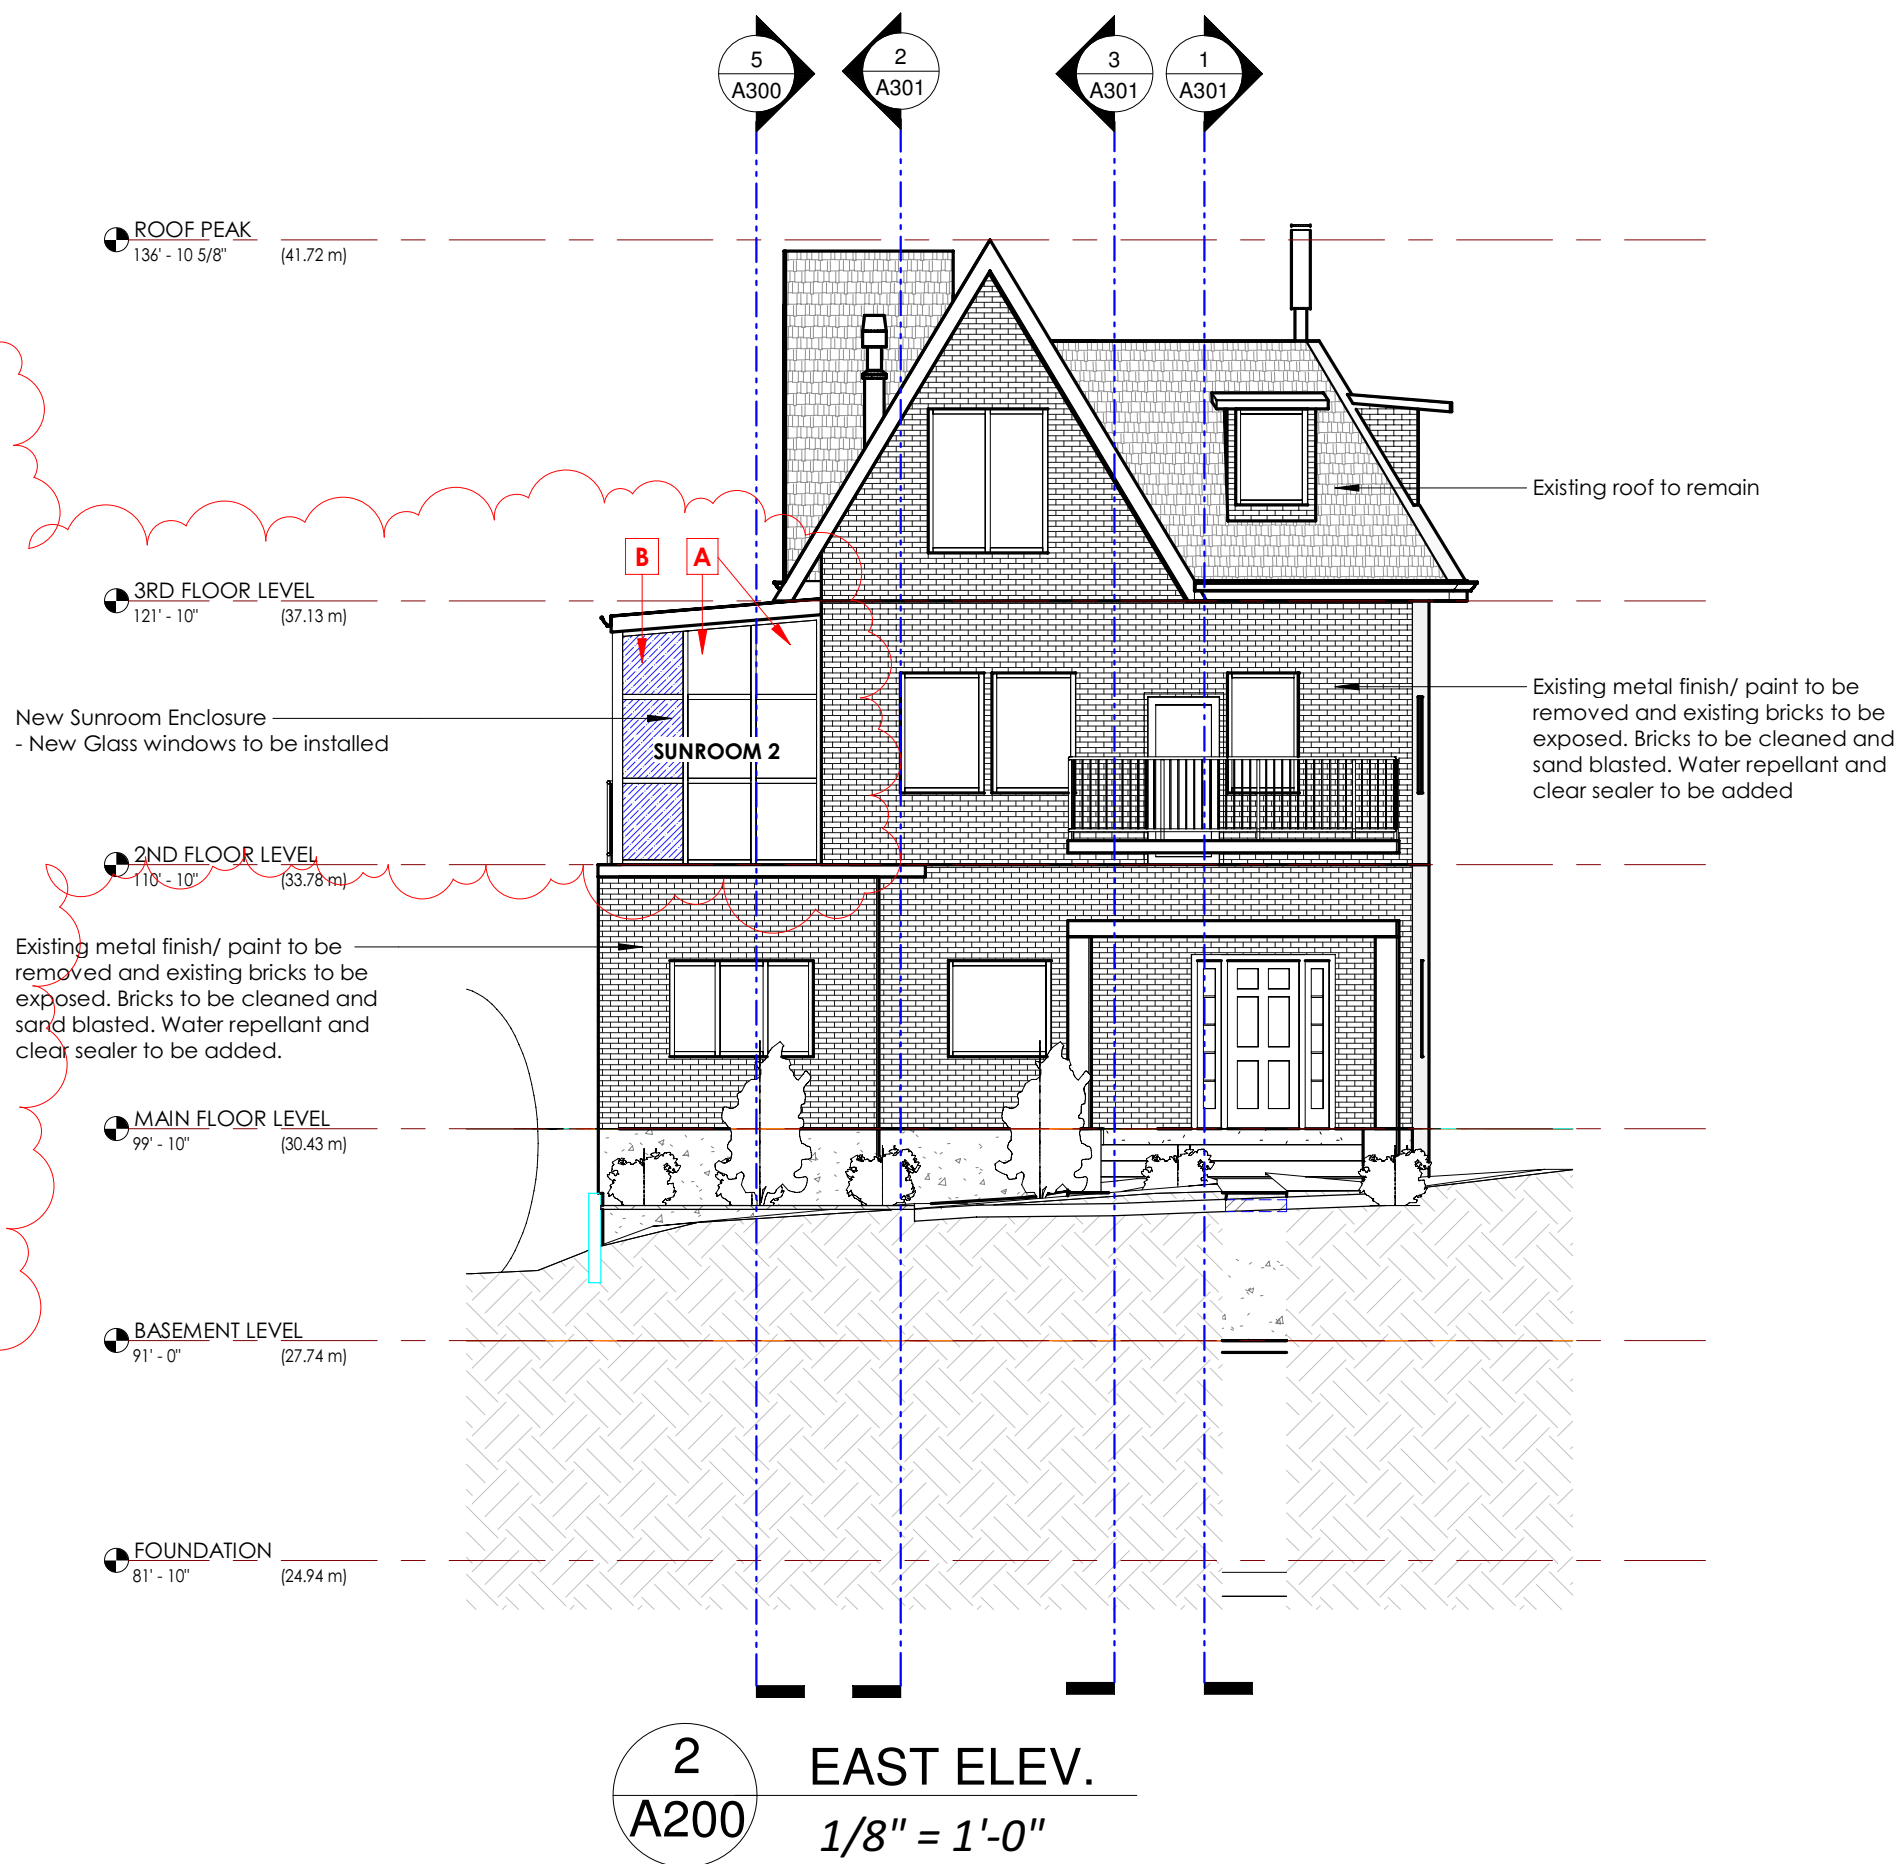

This drawing is the property of William H. Ross Architect Ltd. and shall not be reproduced or used in any way without permission. This drawing MUST NOT be scaled. Any discrepancies are to be reported to the architect for adjustment prior to construction.

william h. ross architect ltd.
3rd floor, 10318-111st edmonton, ab. t5k 1t2
tel. 780. 482. 3495
fax. 780. 488. 0725
email: whra@shaw.ca




Revision Schedule			
#	Descrp.	Date	By
5	Issued for DP	July 24, 2020	EP
7	Issued for BP	Aug. 18, 2020	EP
9	BP Compliance	Oct. 28, 2020	EP
10	Revised Sunroom & North wall	April 19, 2021	EP
11	Revised Sunroom & North wall	April 22, 2021	EP

Proposed: DEVINE PROPERTY
Prepared for: FOR: AMNOR
Address : Edmonton, AB

ELEVATIONS	
dw:	Elsa
date:	07/09/20
scale:	
job #:	1504
sheet :	of :
A200	

REVISED
DRAWING

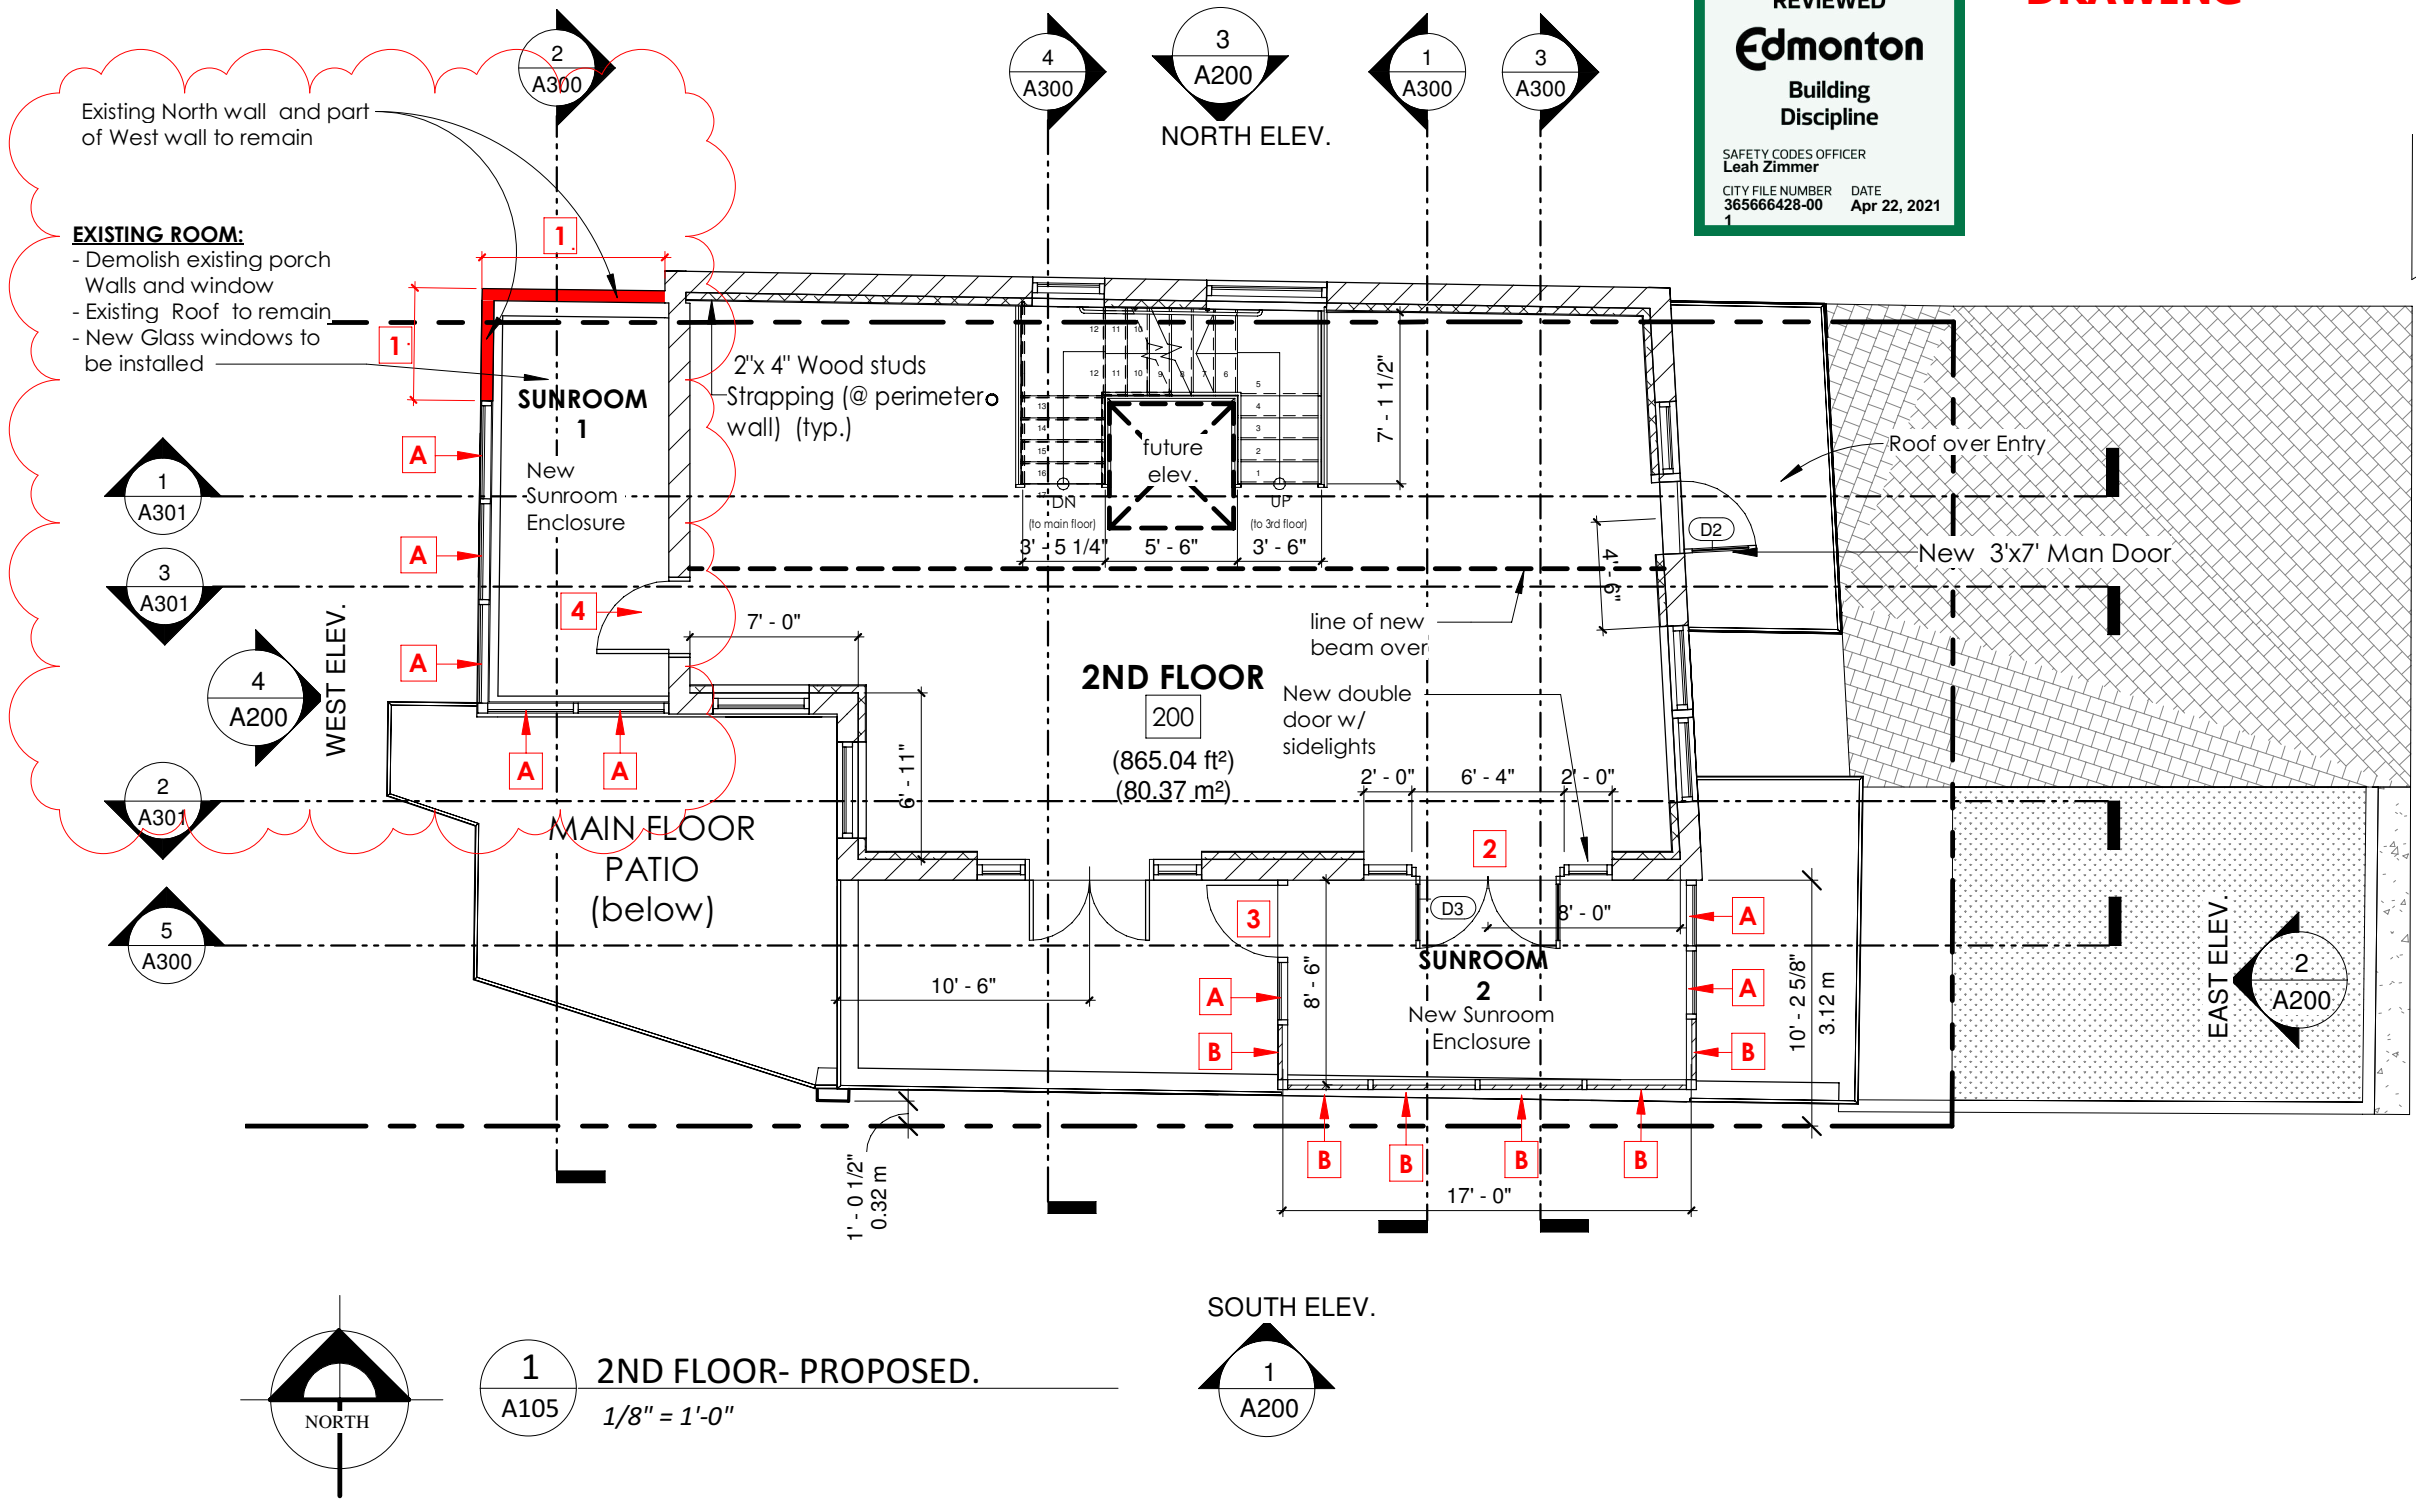

SUNROOM DOOR & WINDOW SCHEDULE:

- 1** EXISTING NORTH WALL TO REMAIN
- 2** NEW DOUBLE GLASS DOOR WITH SIDELIGHTS
- 3** NEW GLASS DOOR
- 4** NEW DOOR TO SUITE EXISTING OPENING
- A** STANDARD GLASS PANELS
- B** POLYCARBONATE PANELS (SEE SPECIFICATIONS)

NOTE:
SEE STRUCTURAL DRAWINGS FOR SUNROOM ENCLOSURE DETAILS

(Revised Sunroom & North wall)
April 22, 2021

4/22/2021 9:41:07 AM

This drawing is the property of William H. Ross Architect Ltd, and shall not be reproduced or used in any way without permission. This drawing MUST NOT be scaled. Any discrepancies are to be reported to the architect for adjustment prior to construction.







DEVINE PROPERTY
Edmonton, AB
FOR: AMNOR

Revision Schedule			
#	Descrip.	Date	By
10	Revised Sunroom & North wall	April 19, 2021	EP
11	Revised Sunroom & North wall	April 22, 2021	


SUNROOM PLAN AND SPECS (DEVINE RESIDENCE)

Project number	1504	A105
Date	Mar. 17, 2021	
Drawn by	EP	
Checked by	Checker	
		Scale 1/8" = 1'-0"

SEE REVISED DRAWING

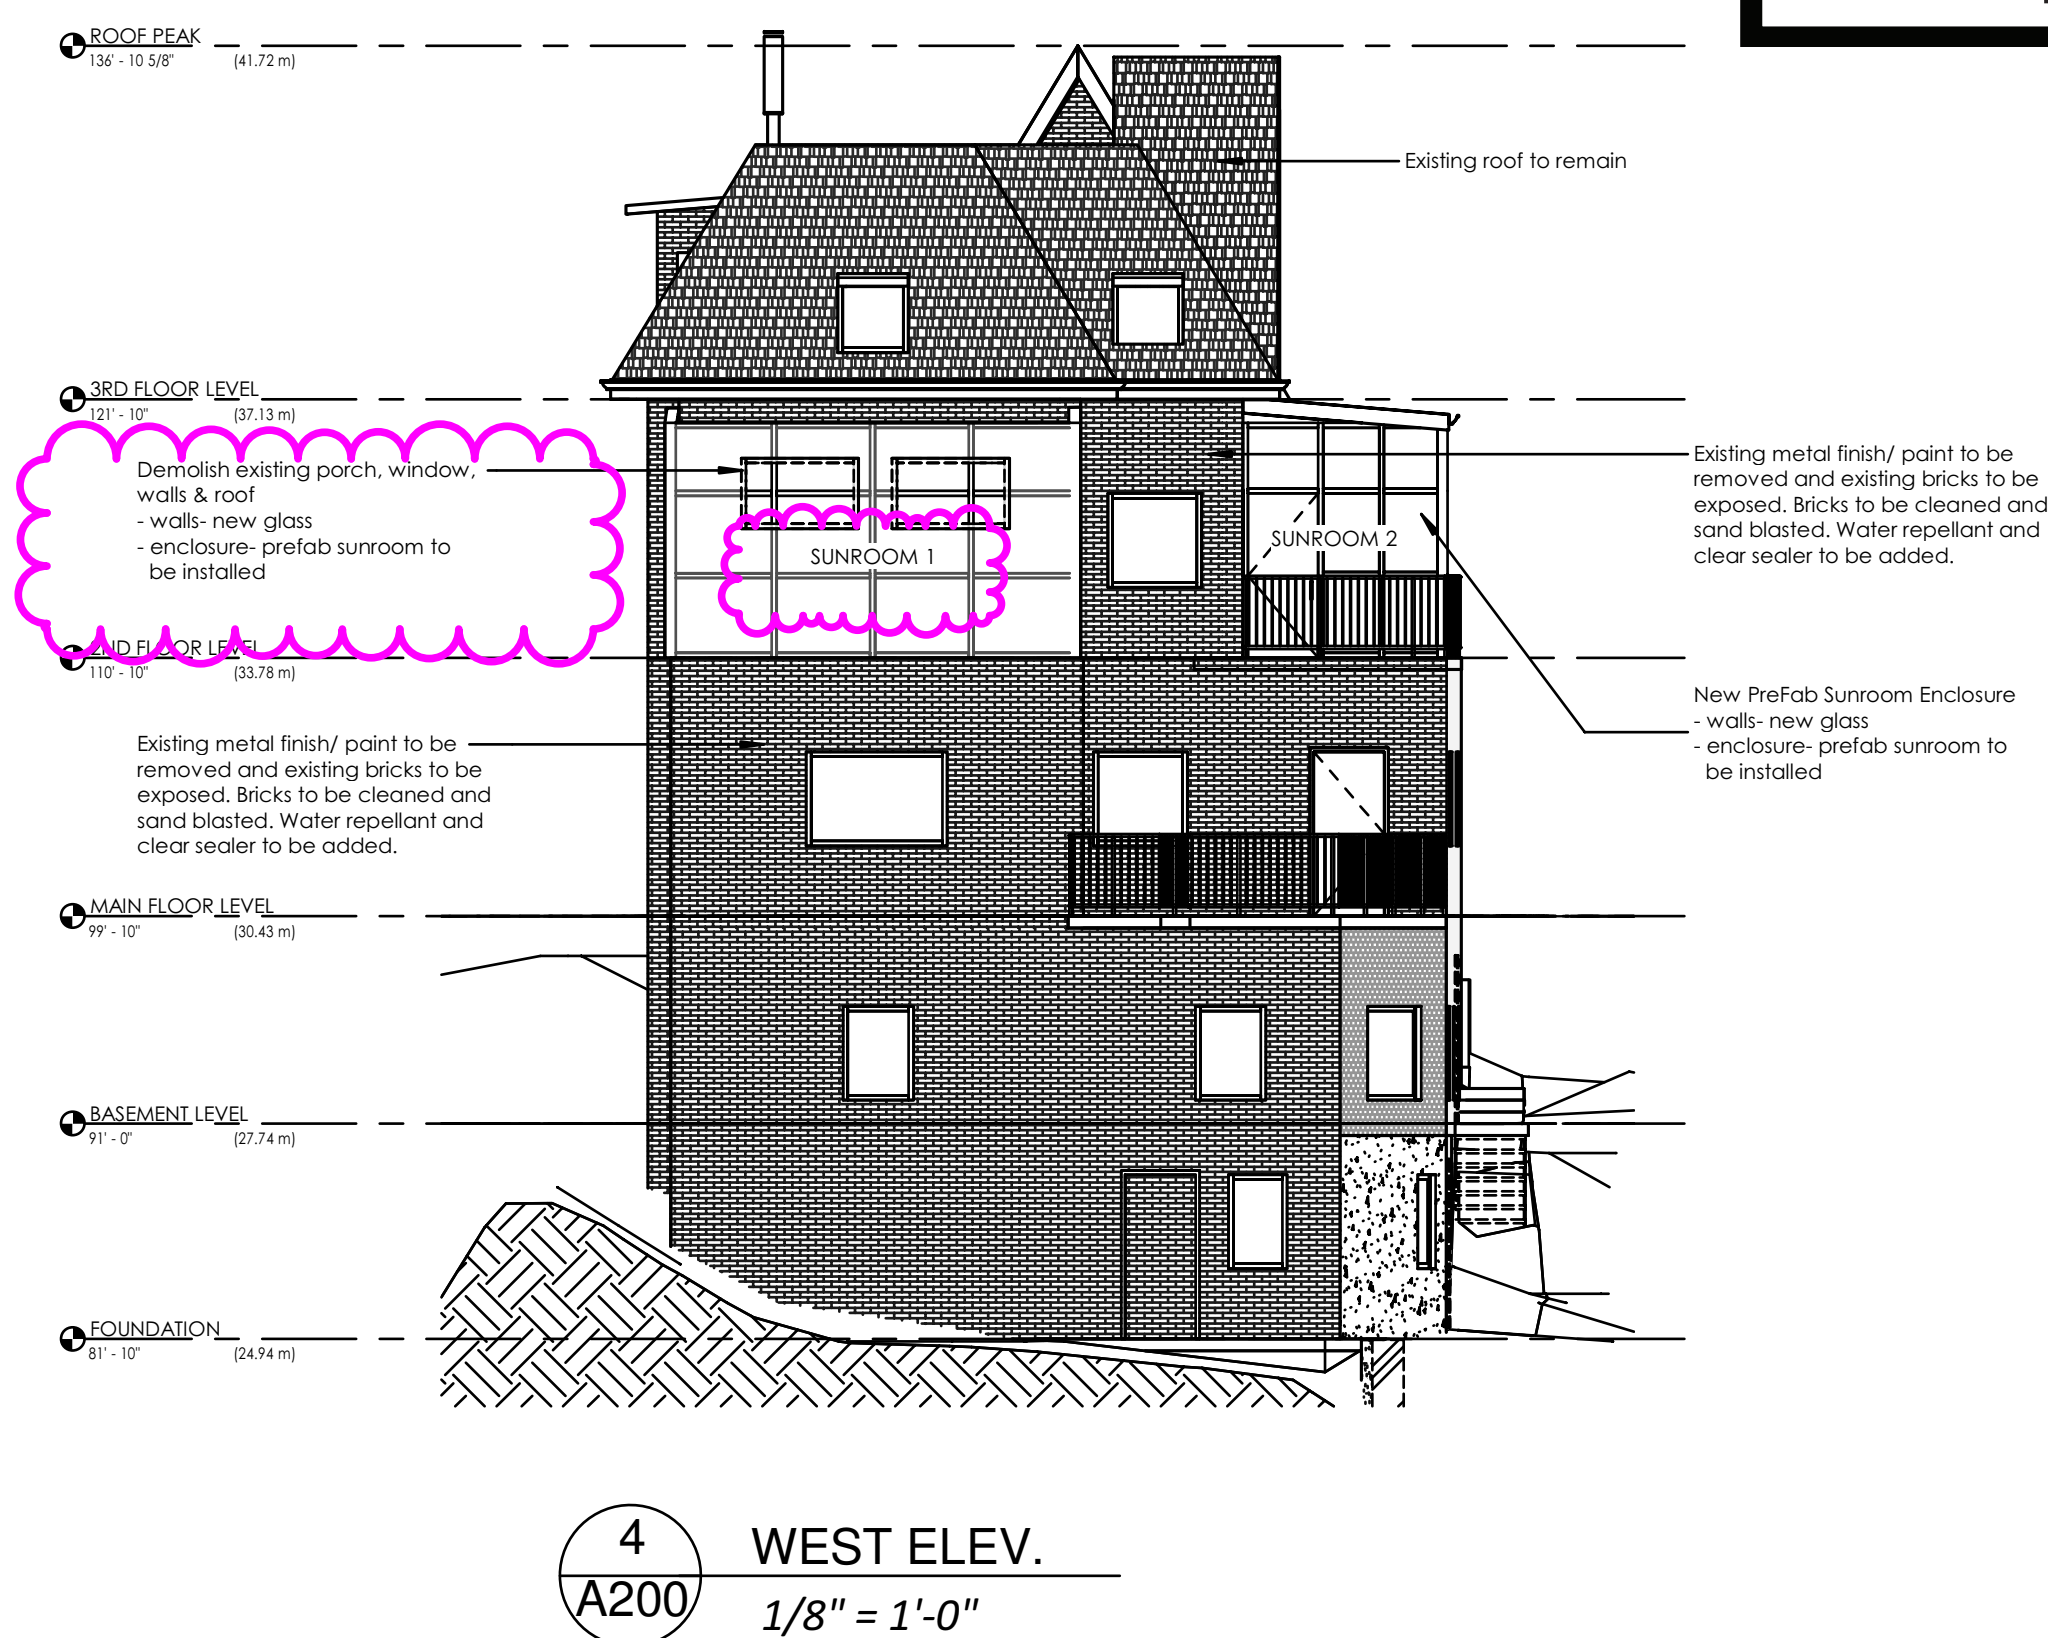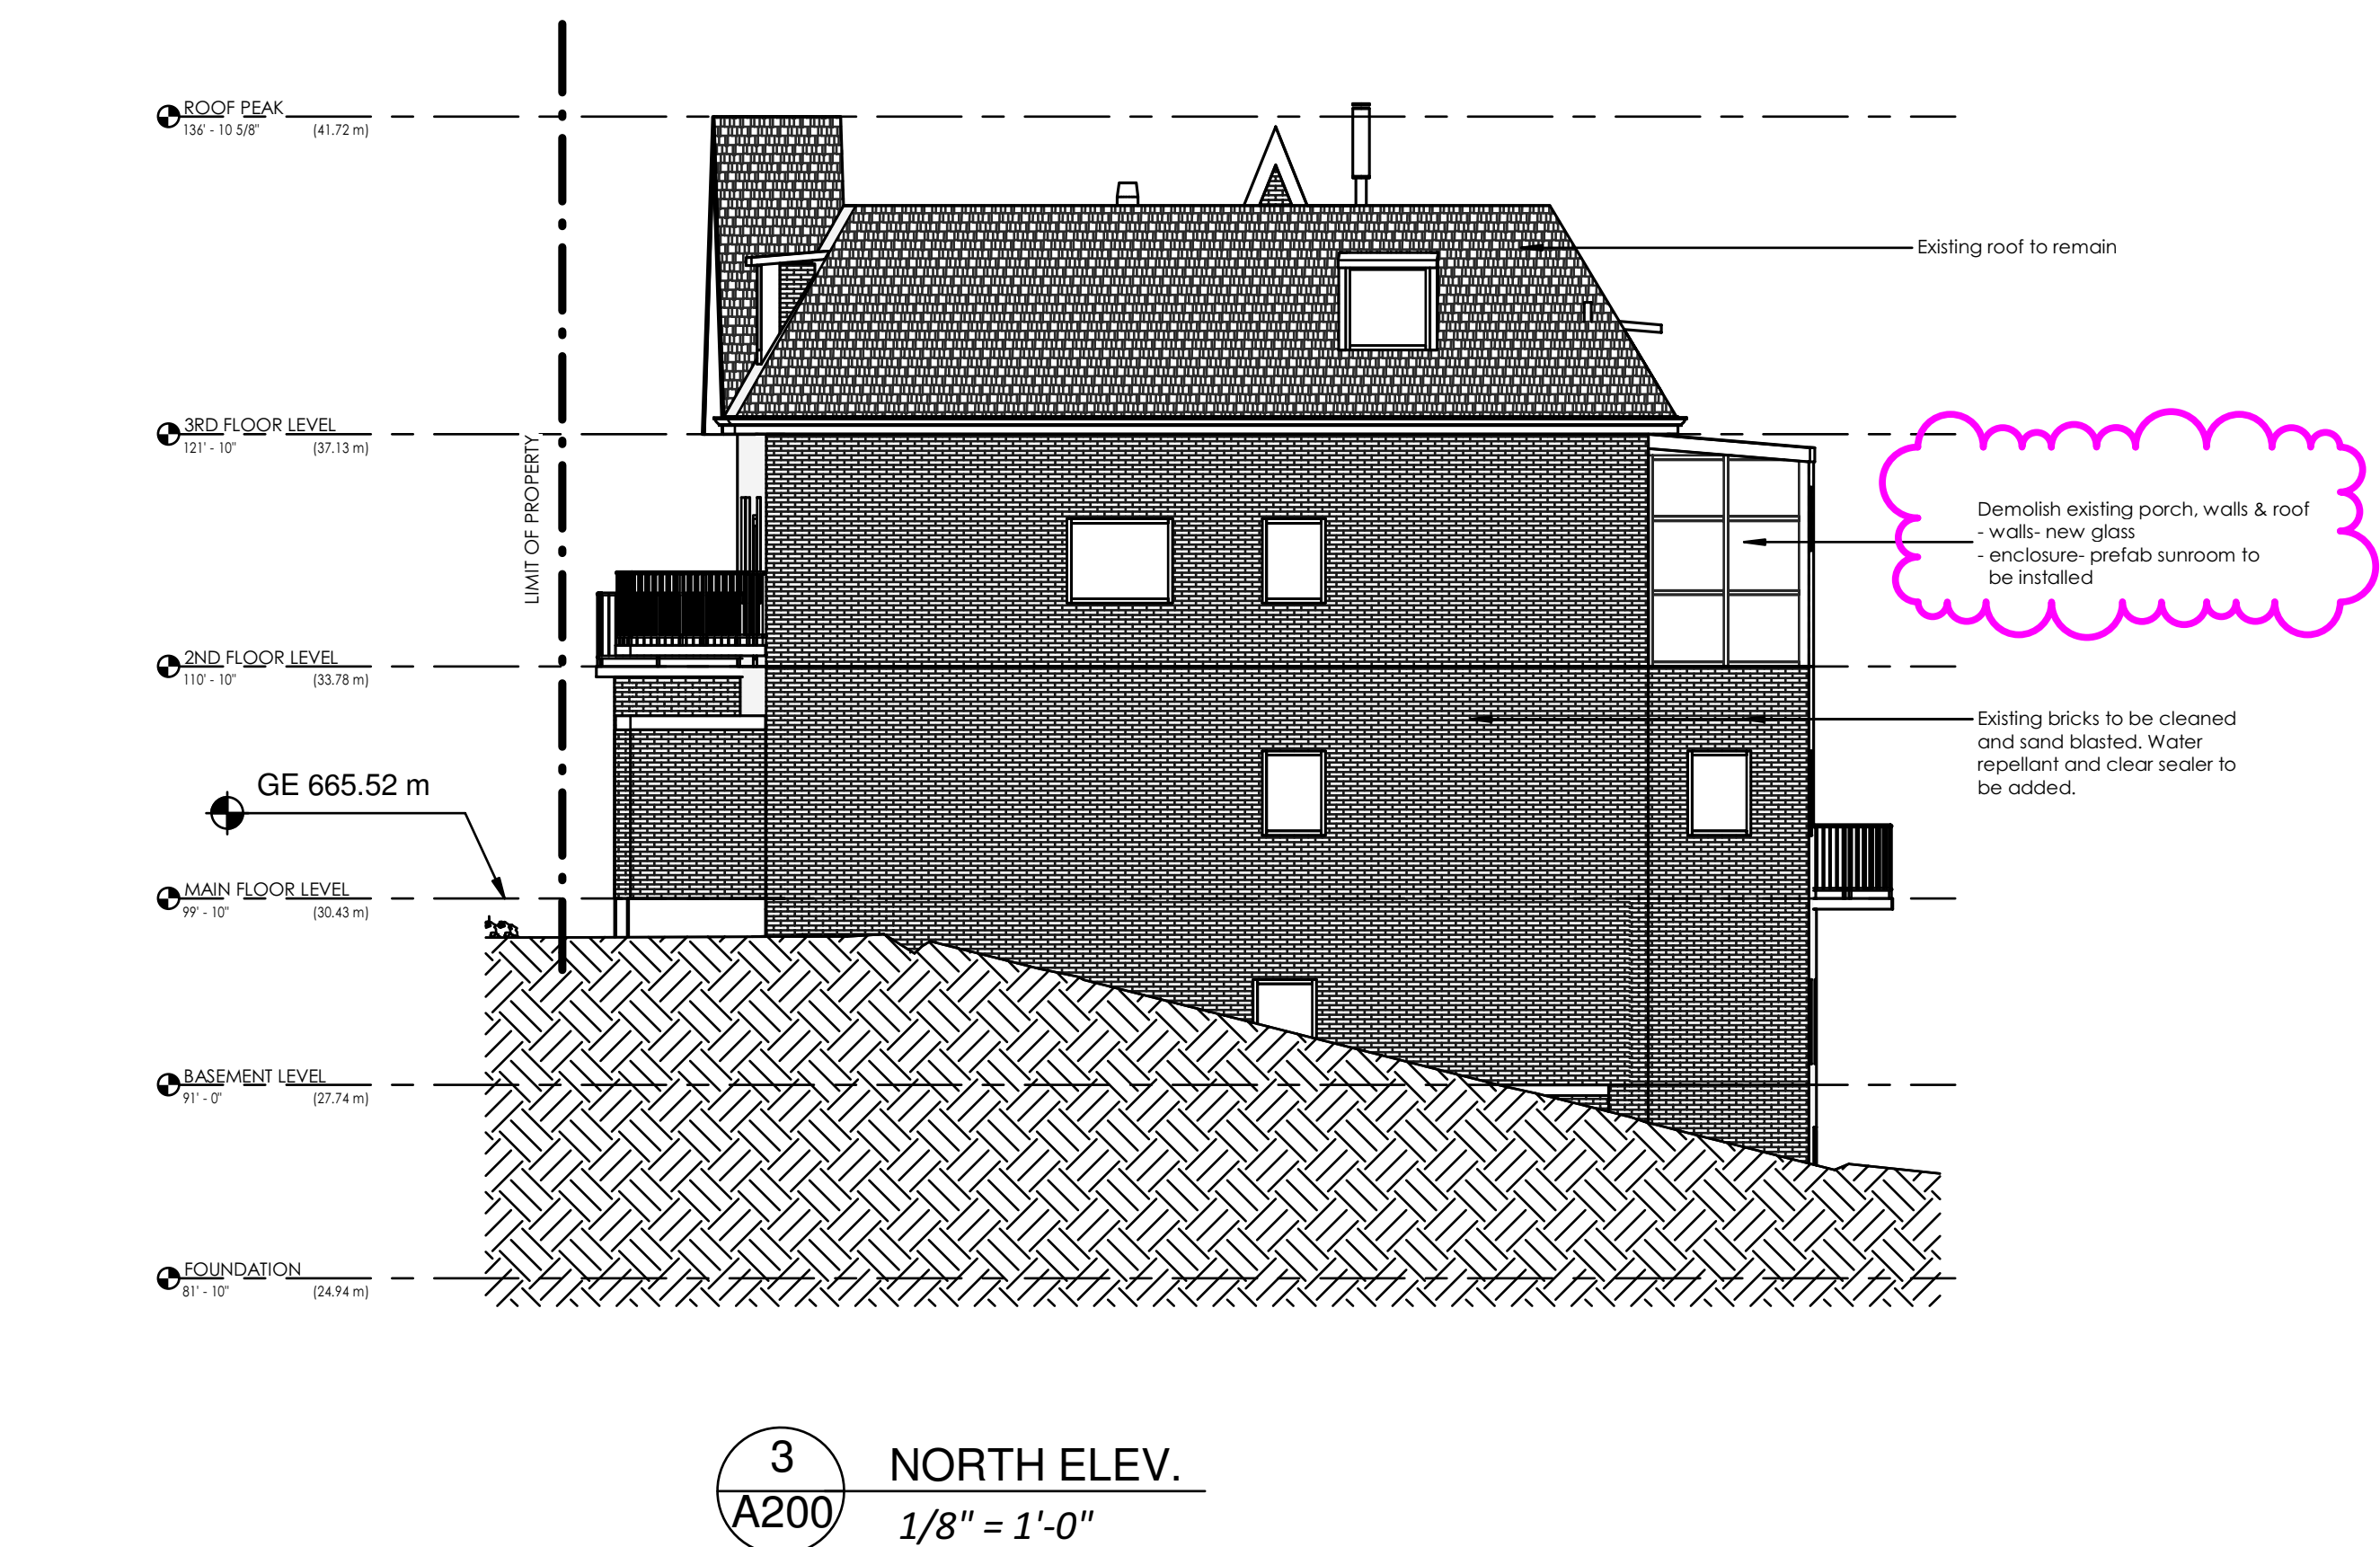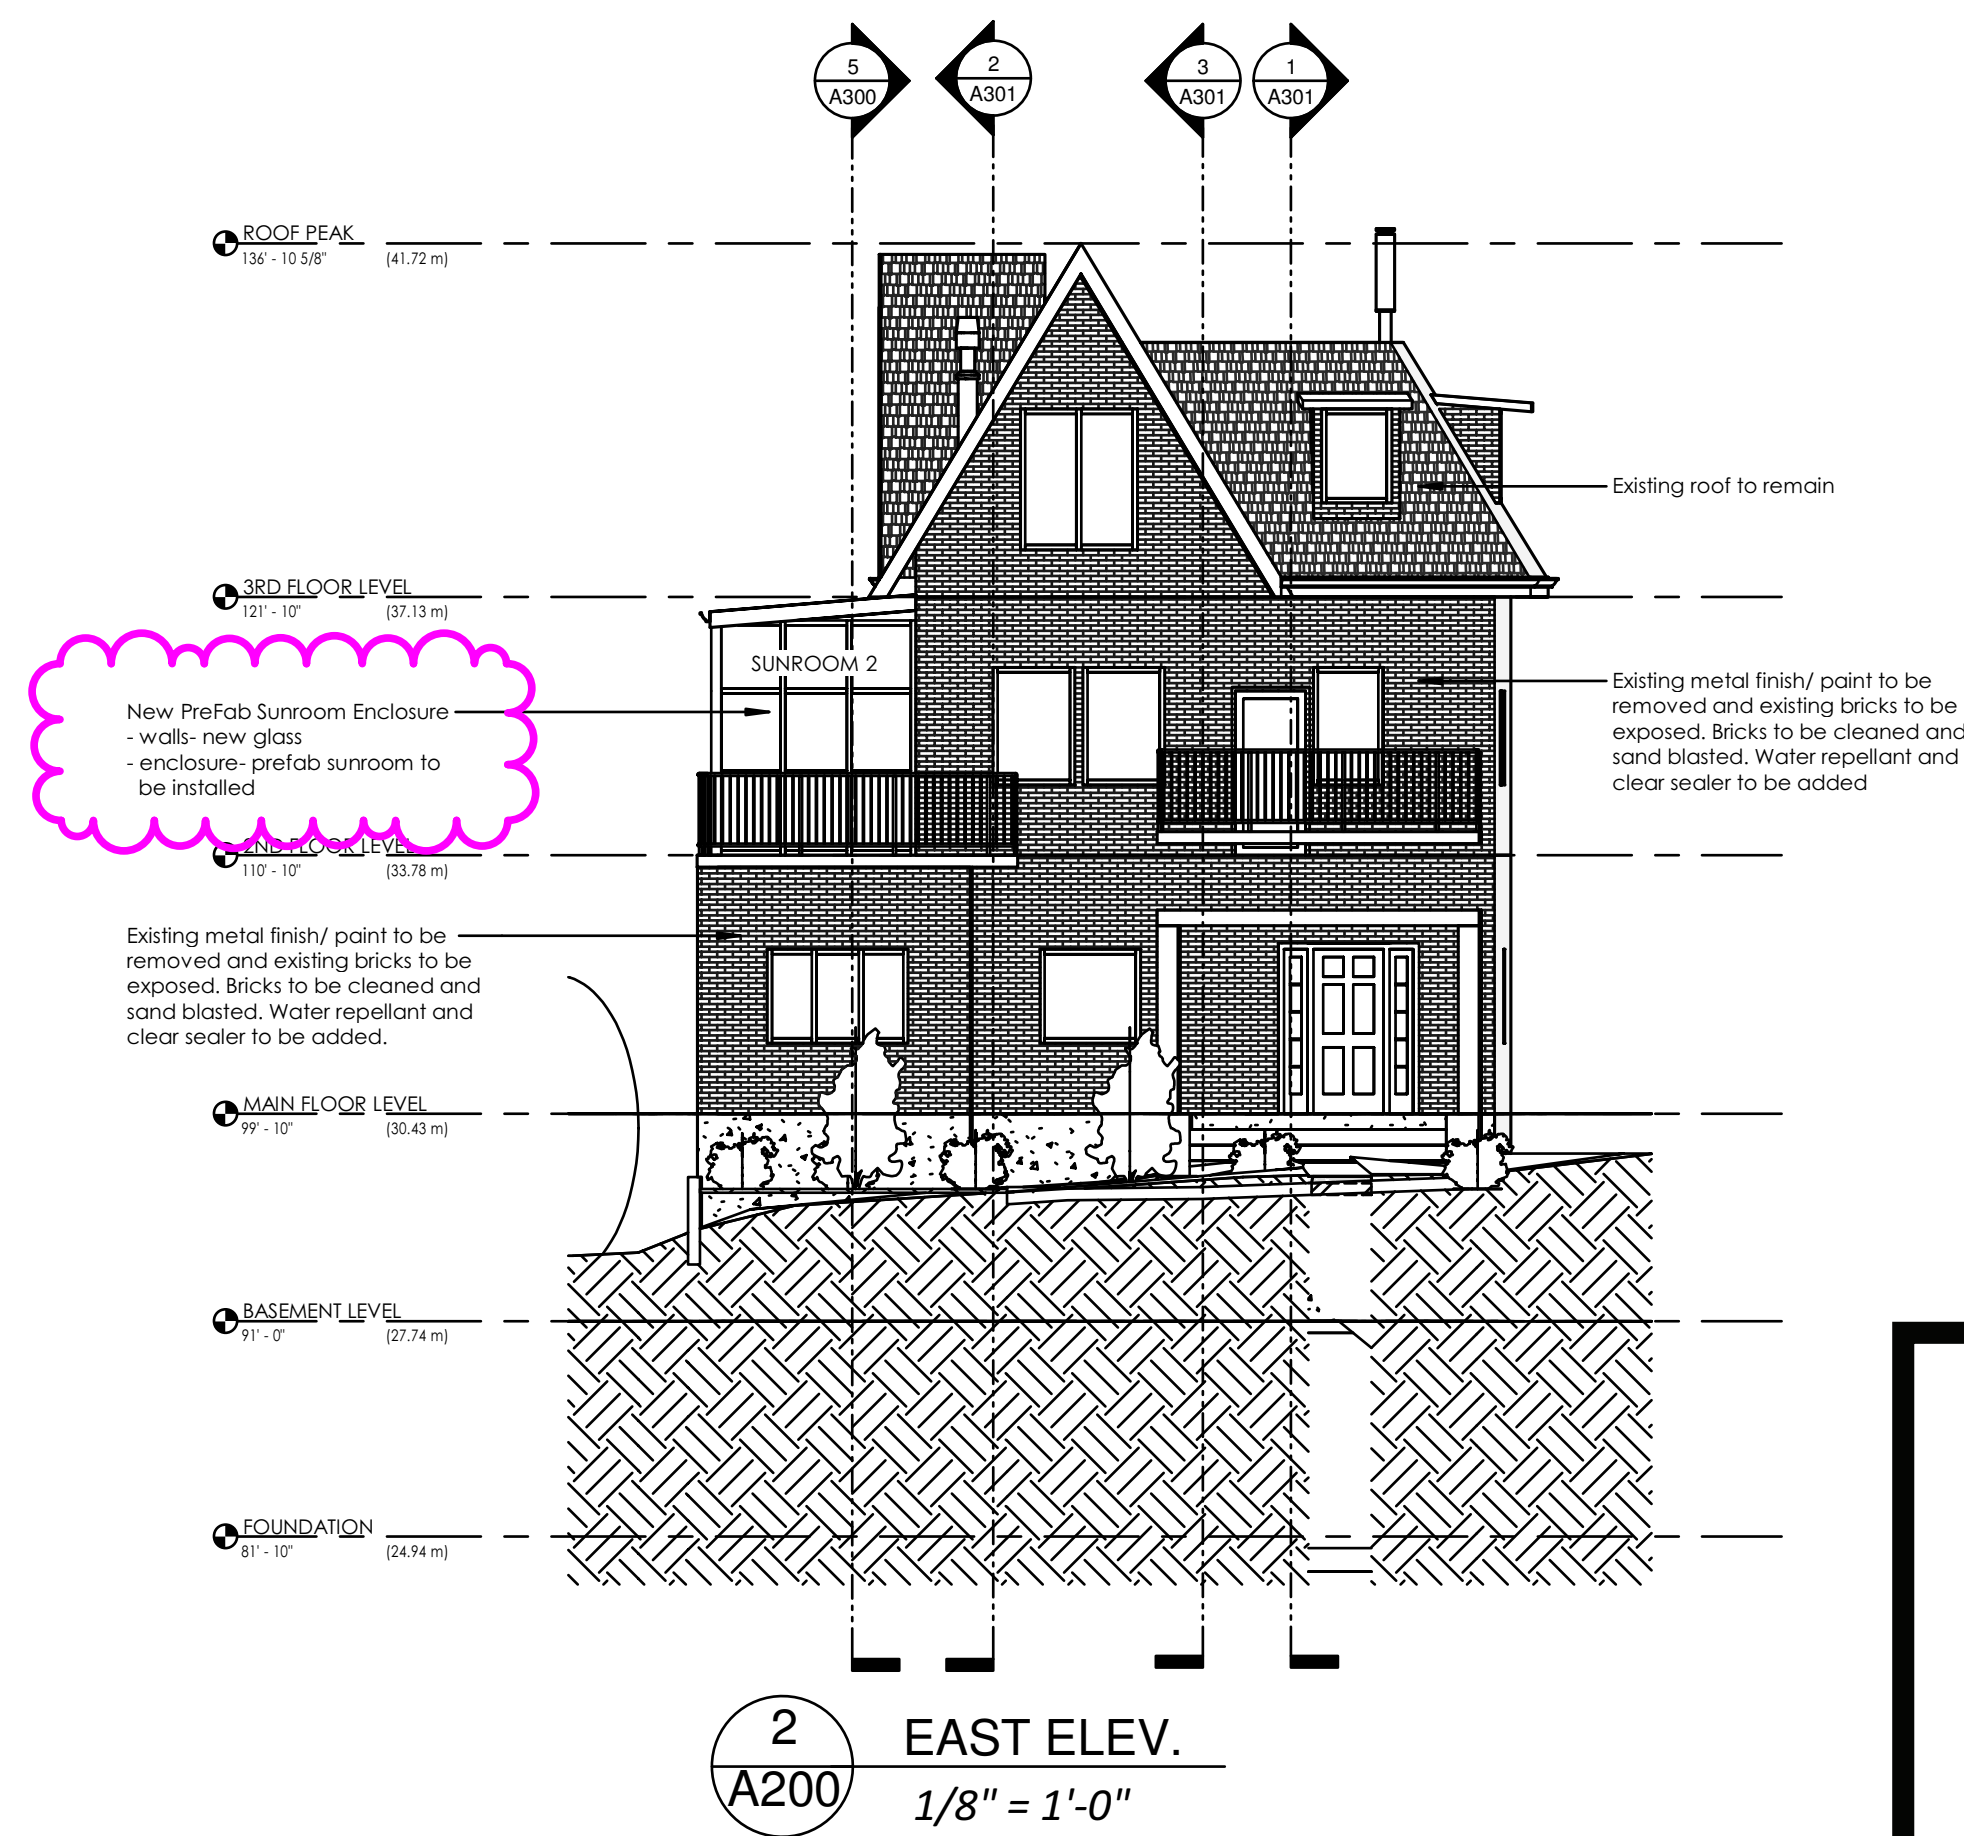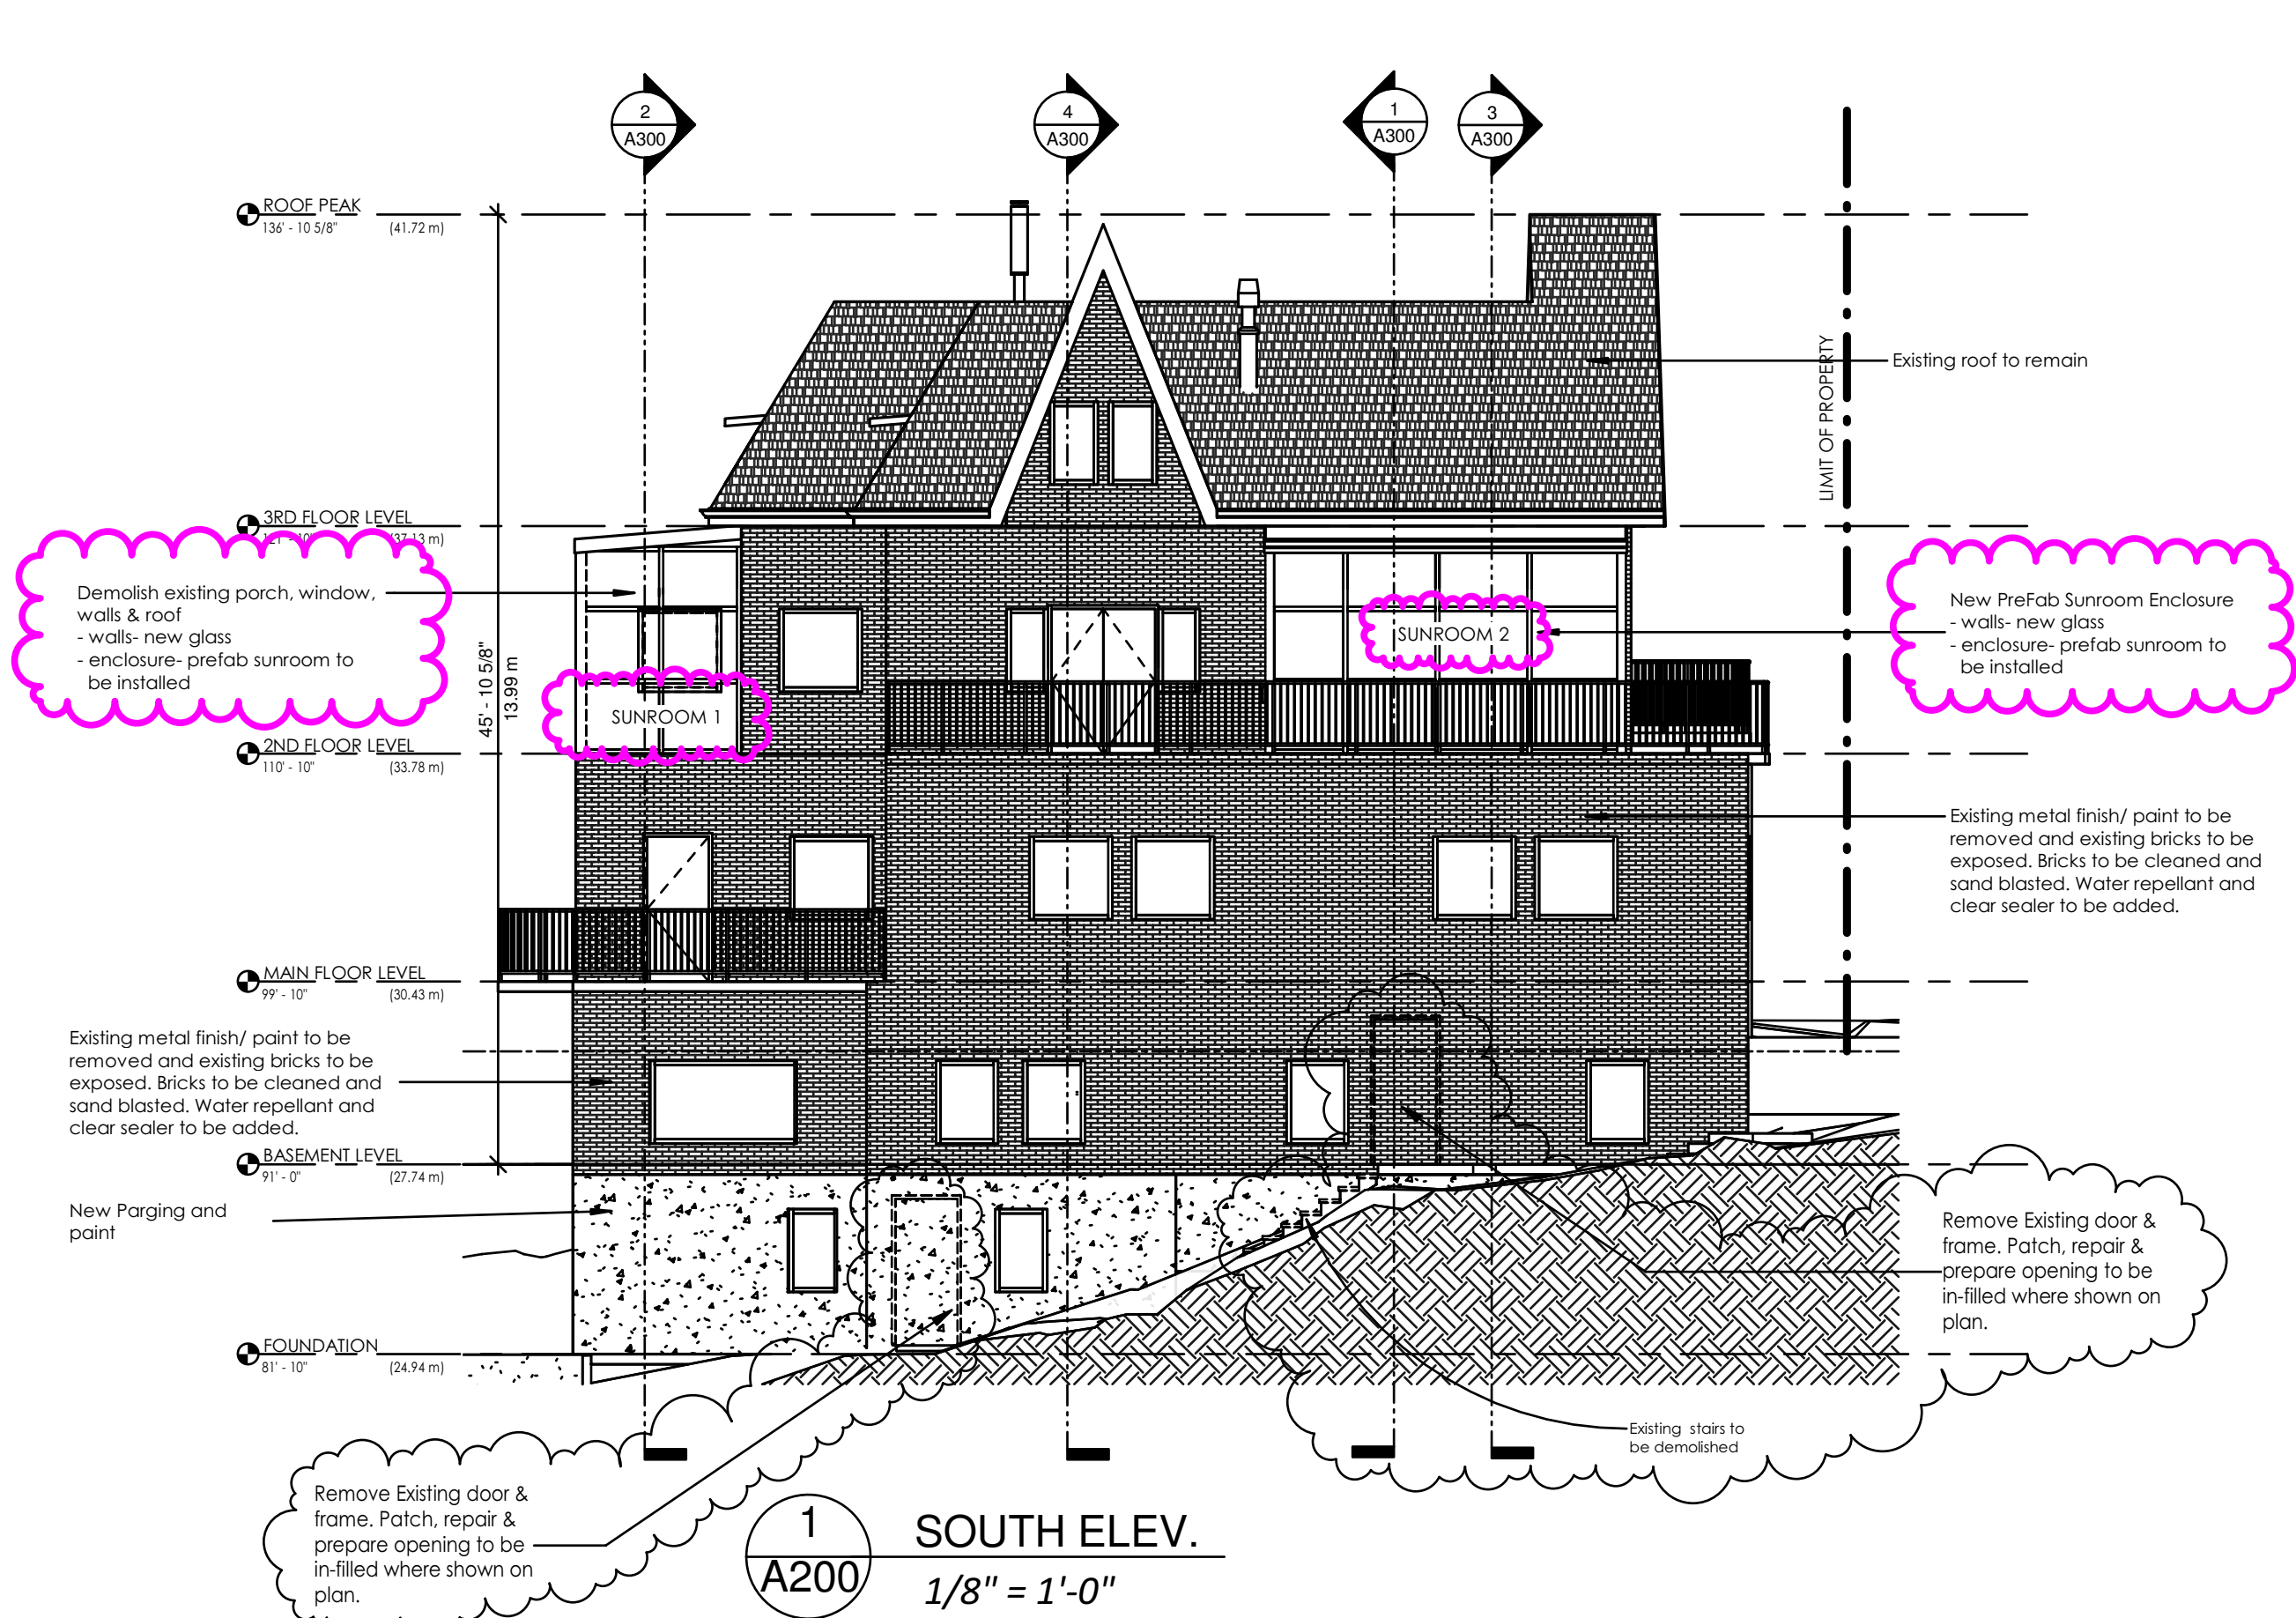

This drawing is the property of William H. Ross Architect Ltd. and shall not be reproduced or used in any way without permission. This drawing MUST NOT be scaled. Any discrepancies are to be reported to the architect for adjustment prior to construction.

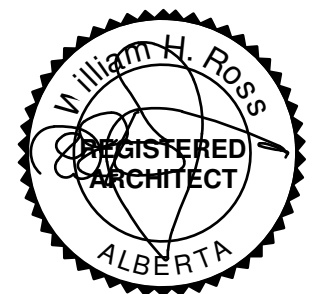

Revision Schedule		
#	Describe	Date
5	Issued for DP	July 24, 2020
7	Issued for BP	Aug. 18, 2020
9	BP Compliance	Oct. 28, 2020



Proposed: DEVINE PROPERTY
Prepared for: HARRY KAURA
Address : Edmonton, AB

ELEVATIONS	
dw: Elsa	
date: 07/09/20	
scale:	
job #: 1504	
sheet : of :	
A200	

BP Compliance
LATEST SUBMISSION

Oct. 28, 2020

10/28/2020 8:17:13 PM

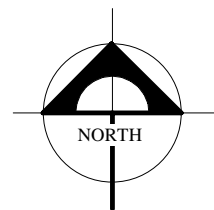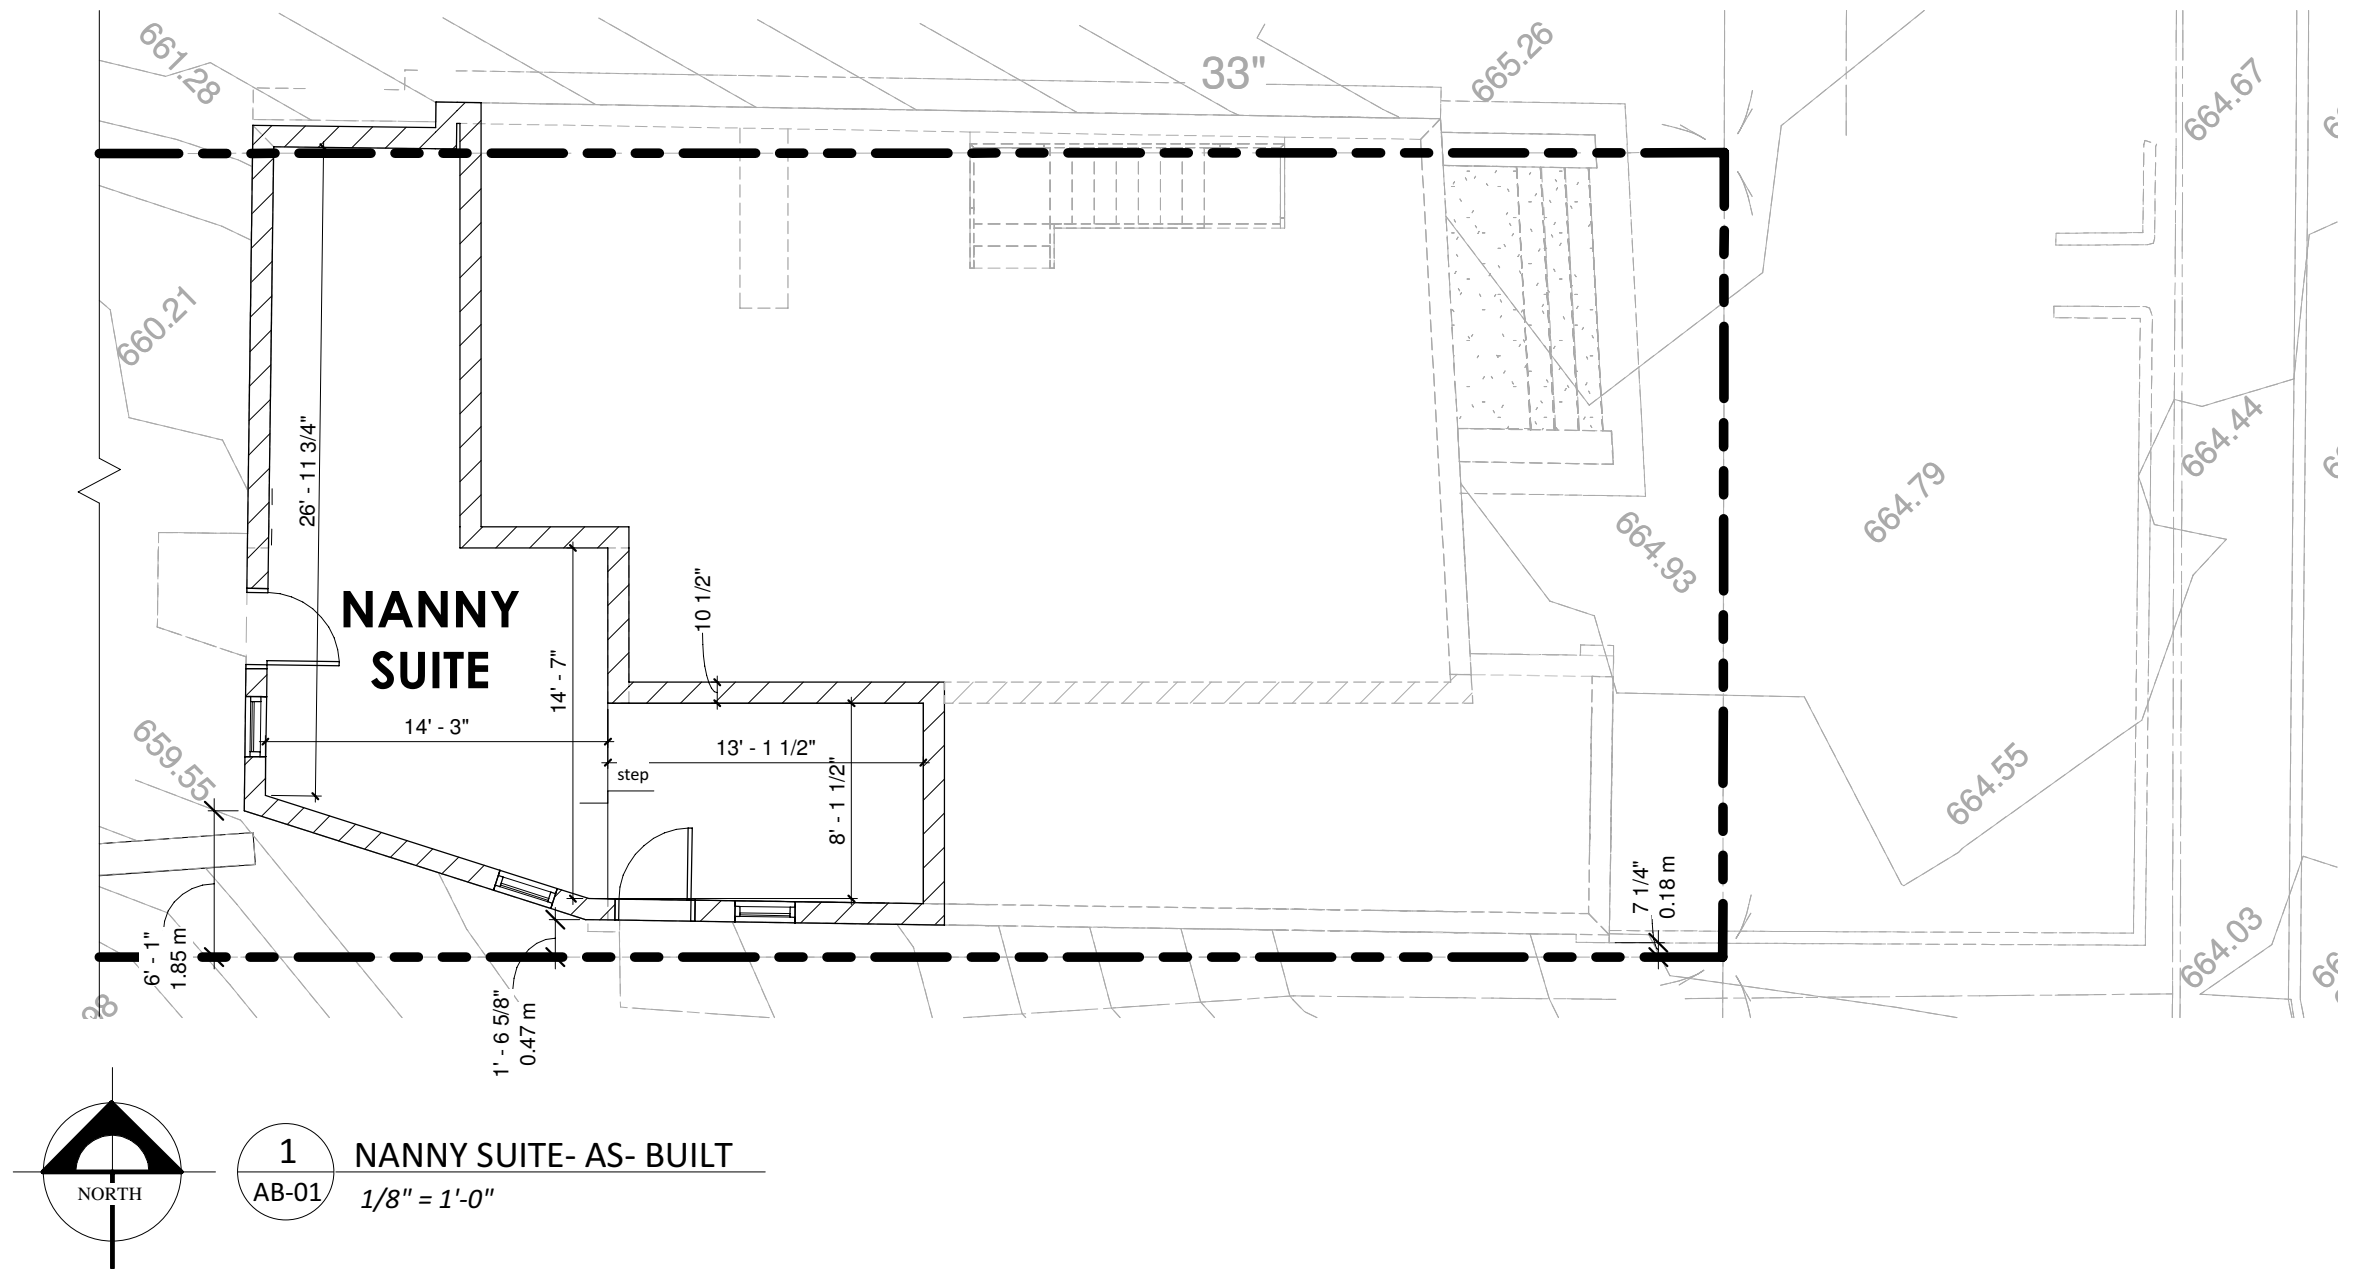

1 NANNY SUITE- AS- BUILT
AB-01 1/8" = 1'-0"


DEVINE PROPERTY

NANNY SUITE

AB-01

6/12/2020 2:15:20 PM



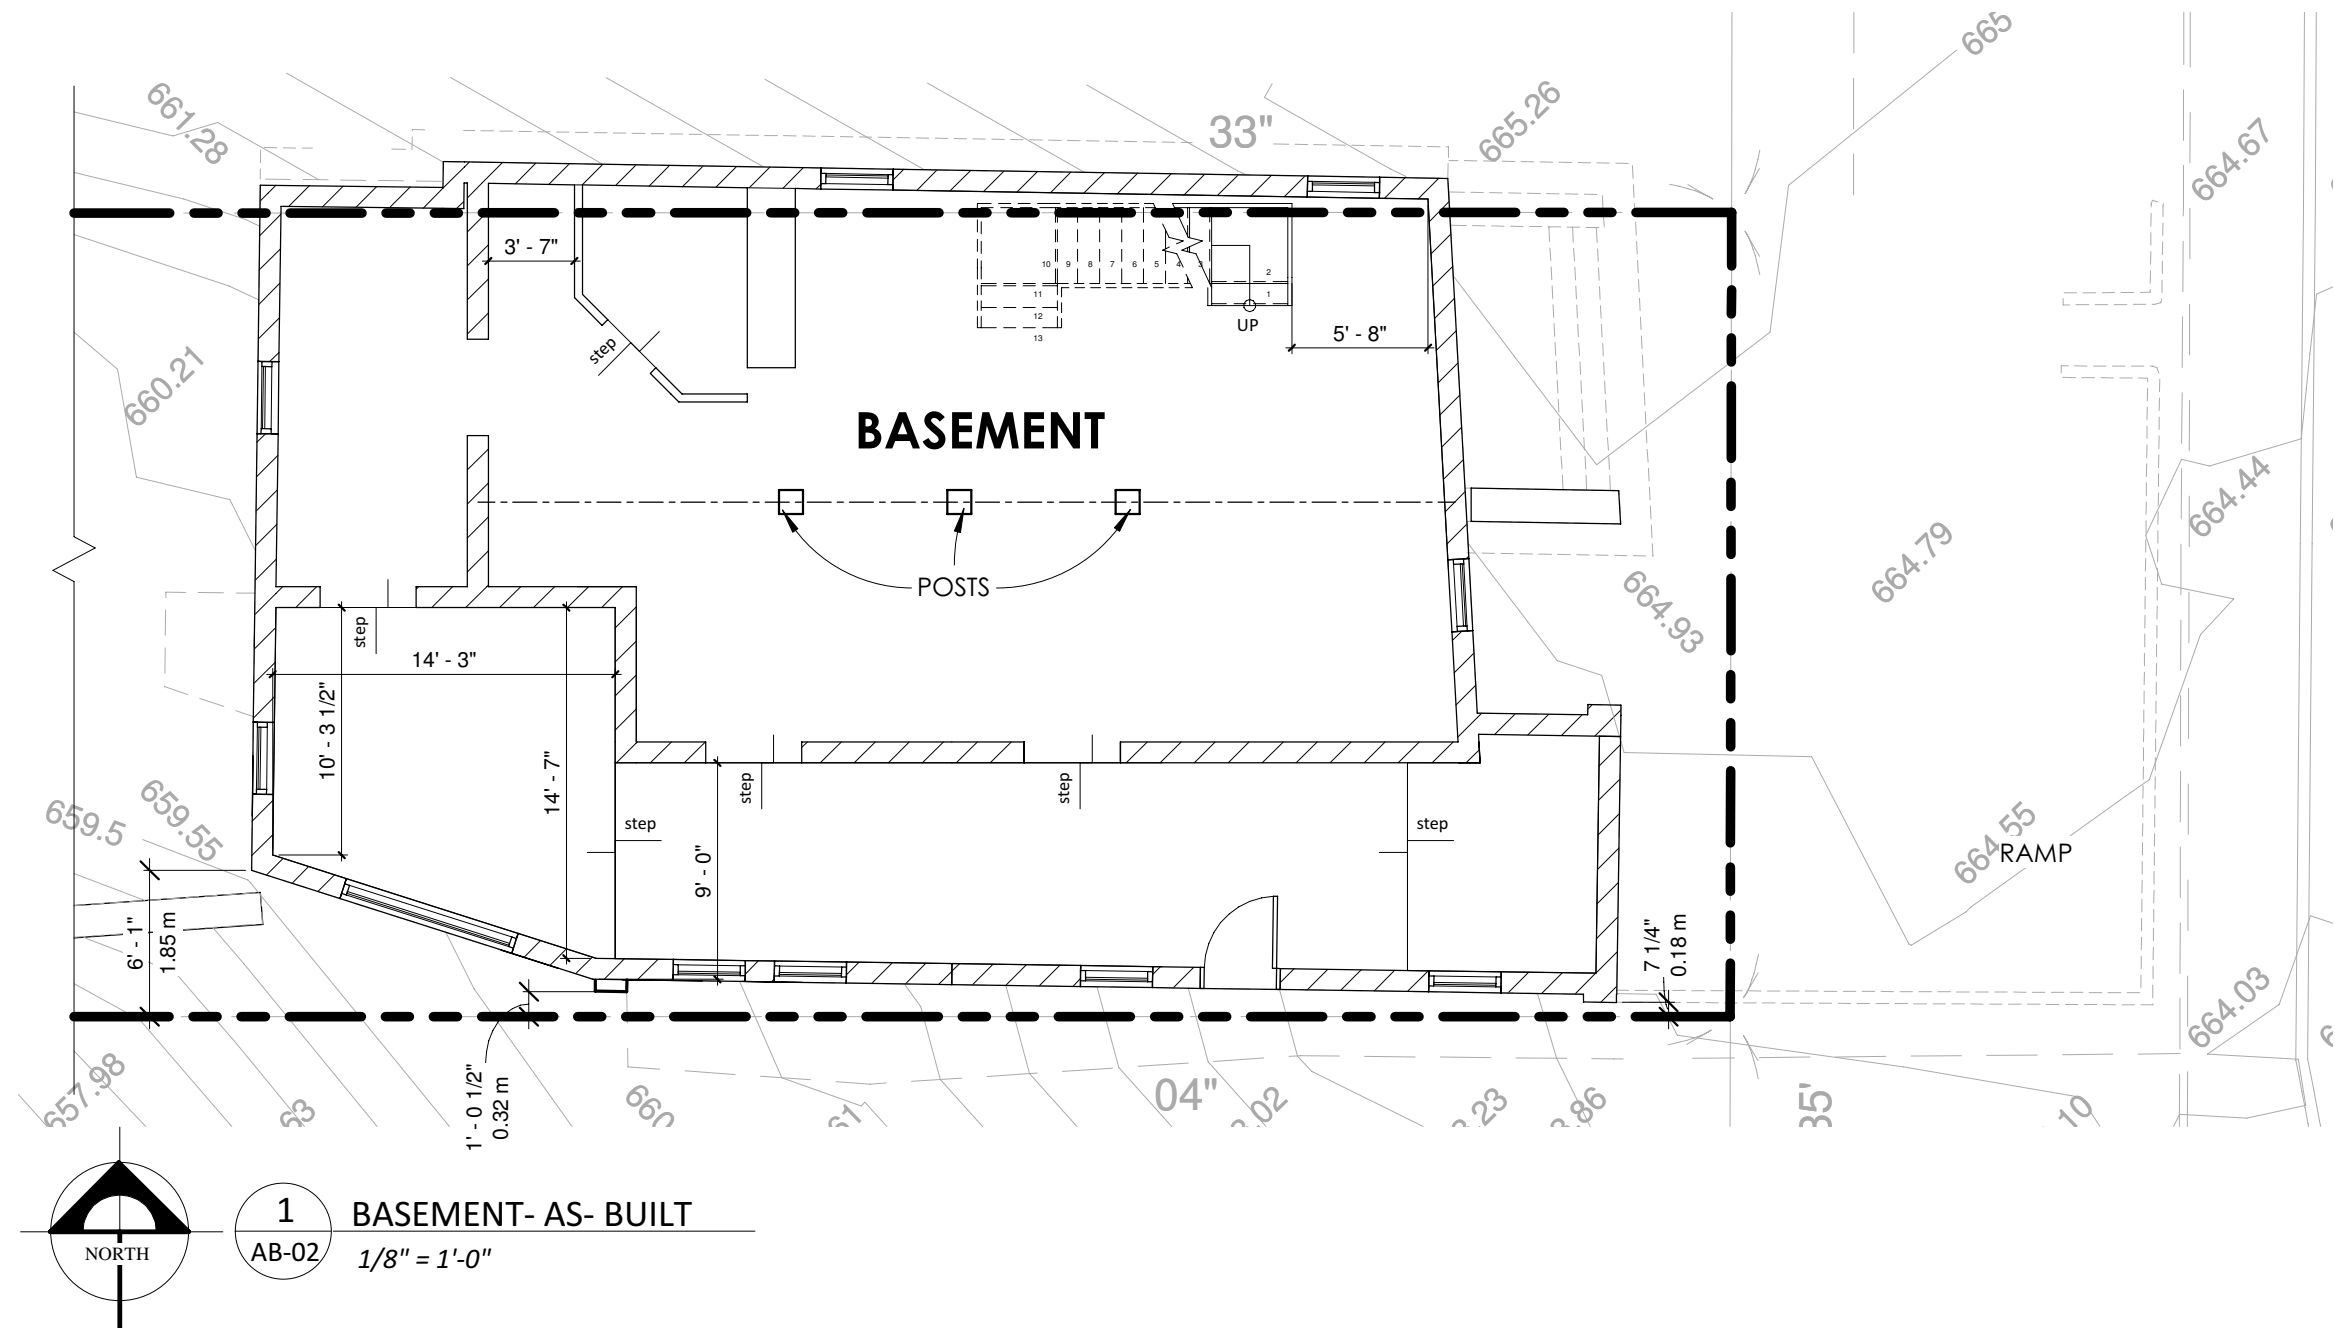


DEVINE PROPERTY

BASEMENT- AS BUILT

AB-02

6/12/2020 2:15:20 PM




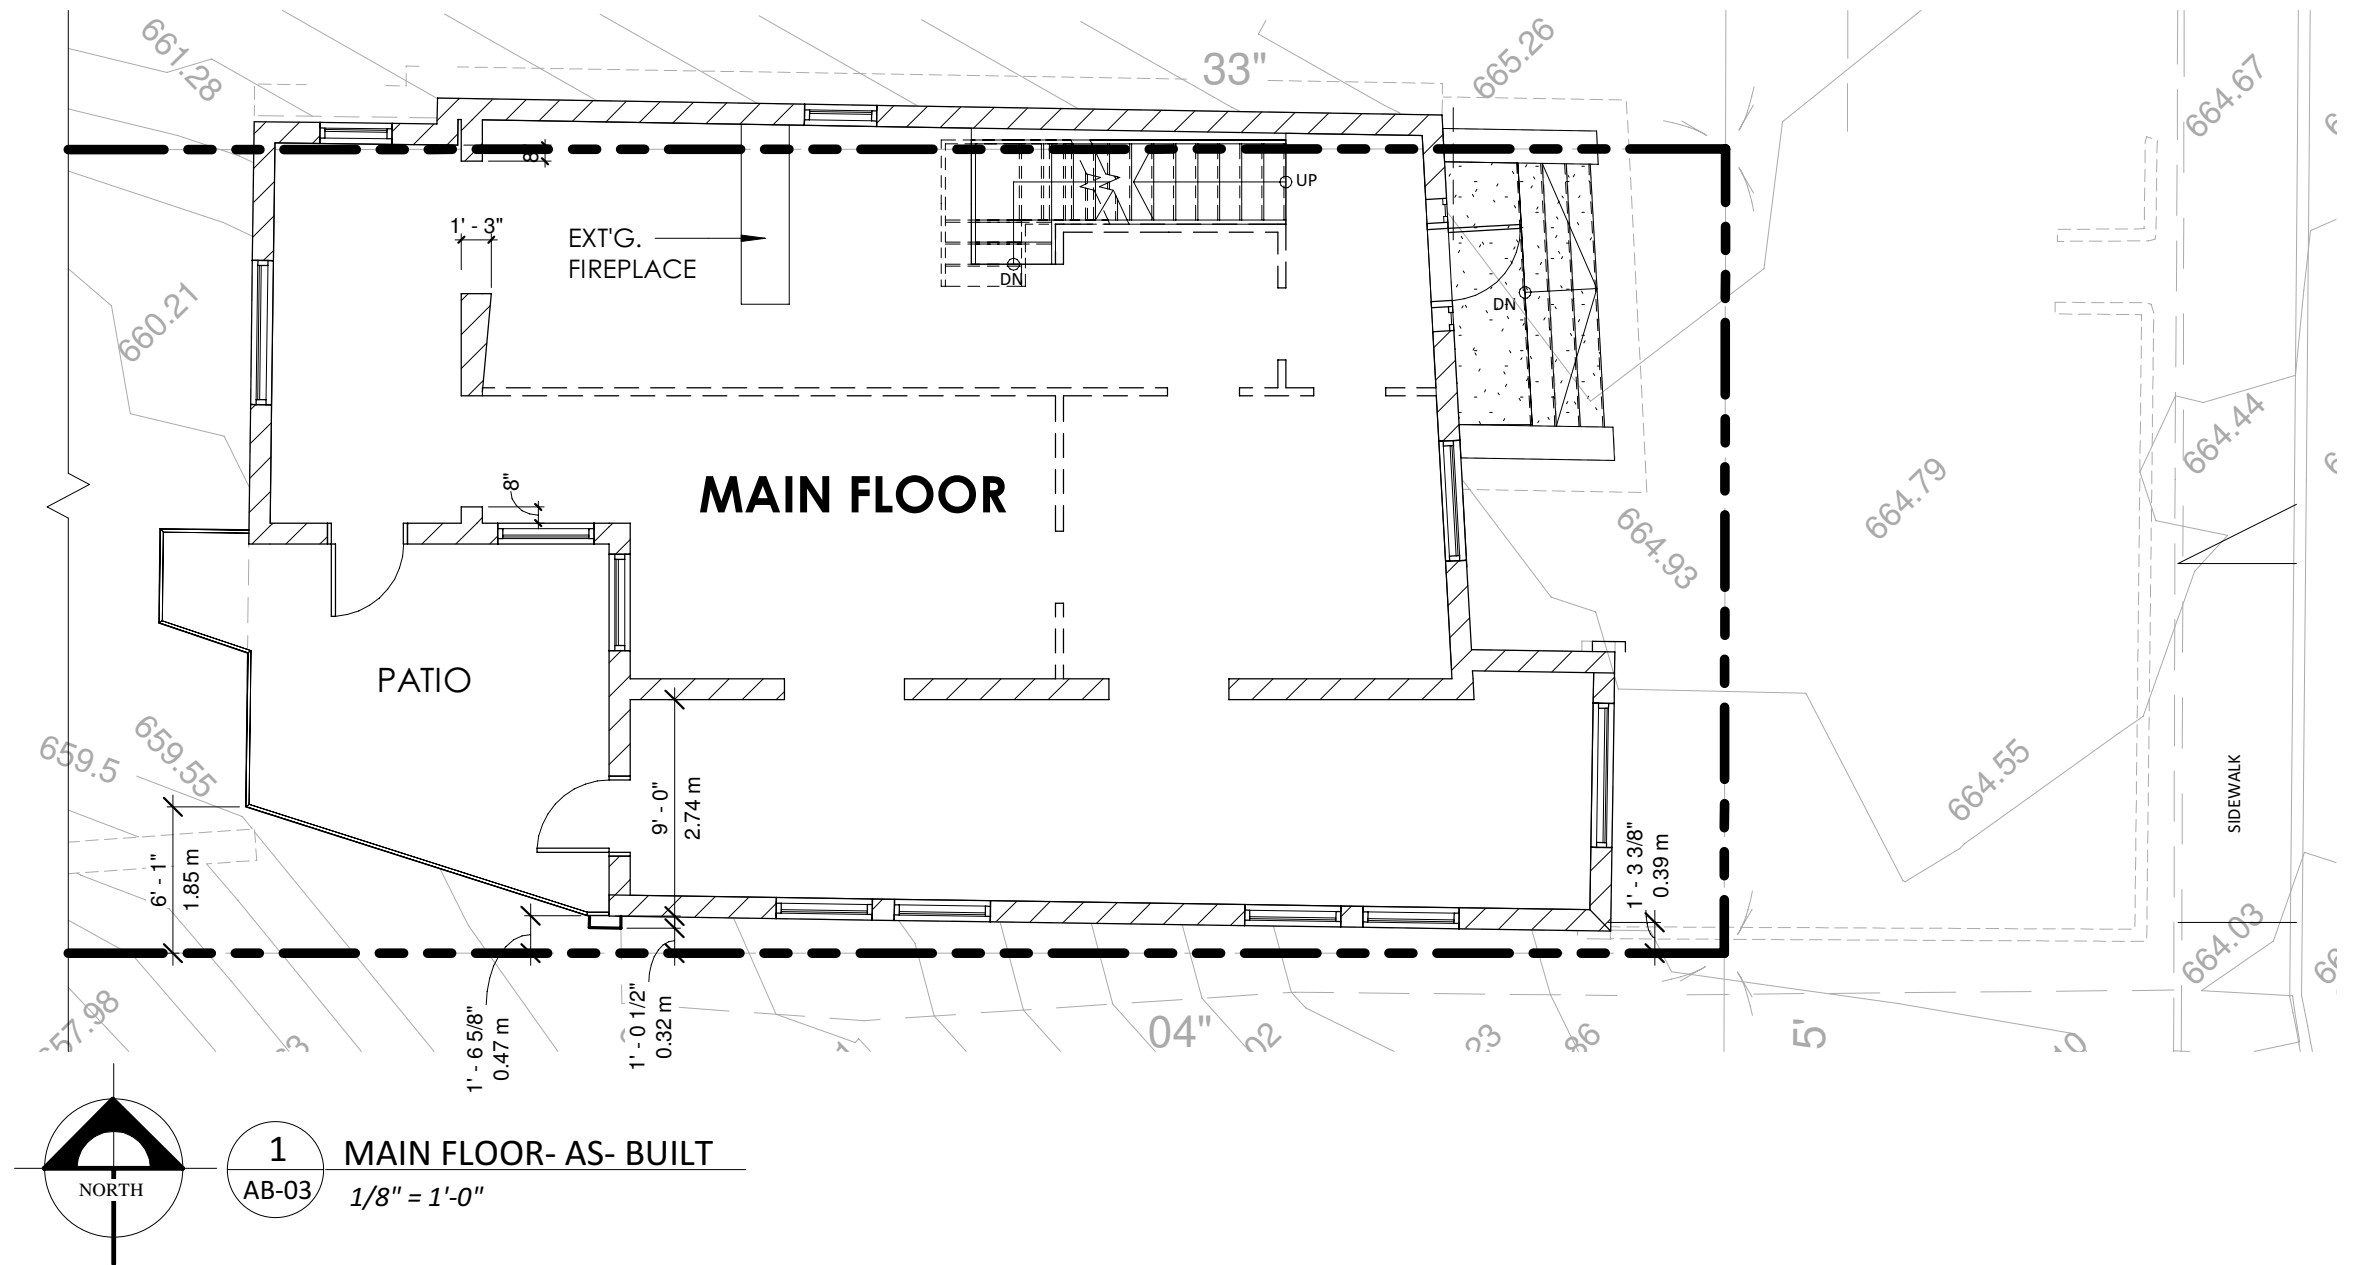

DEVINE PROPERTY
MAIN FLOOR- AS BUILT

AB-03
6/12/2020 2:15:20 PM



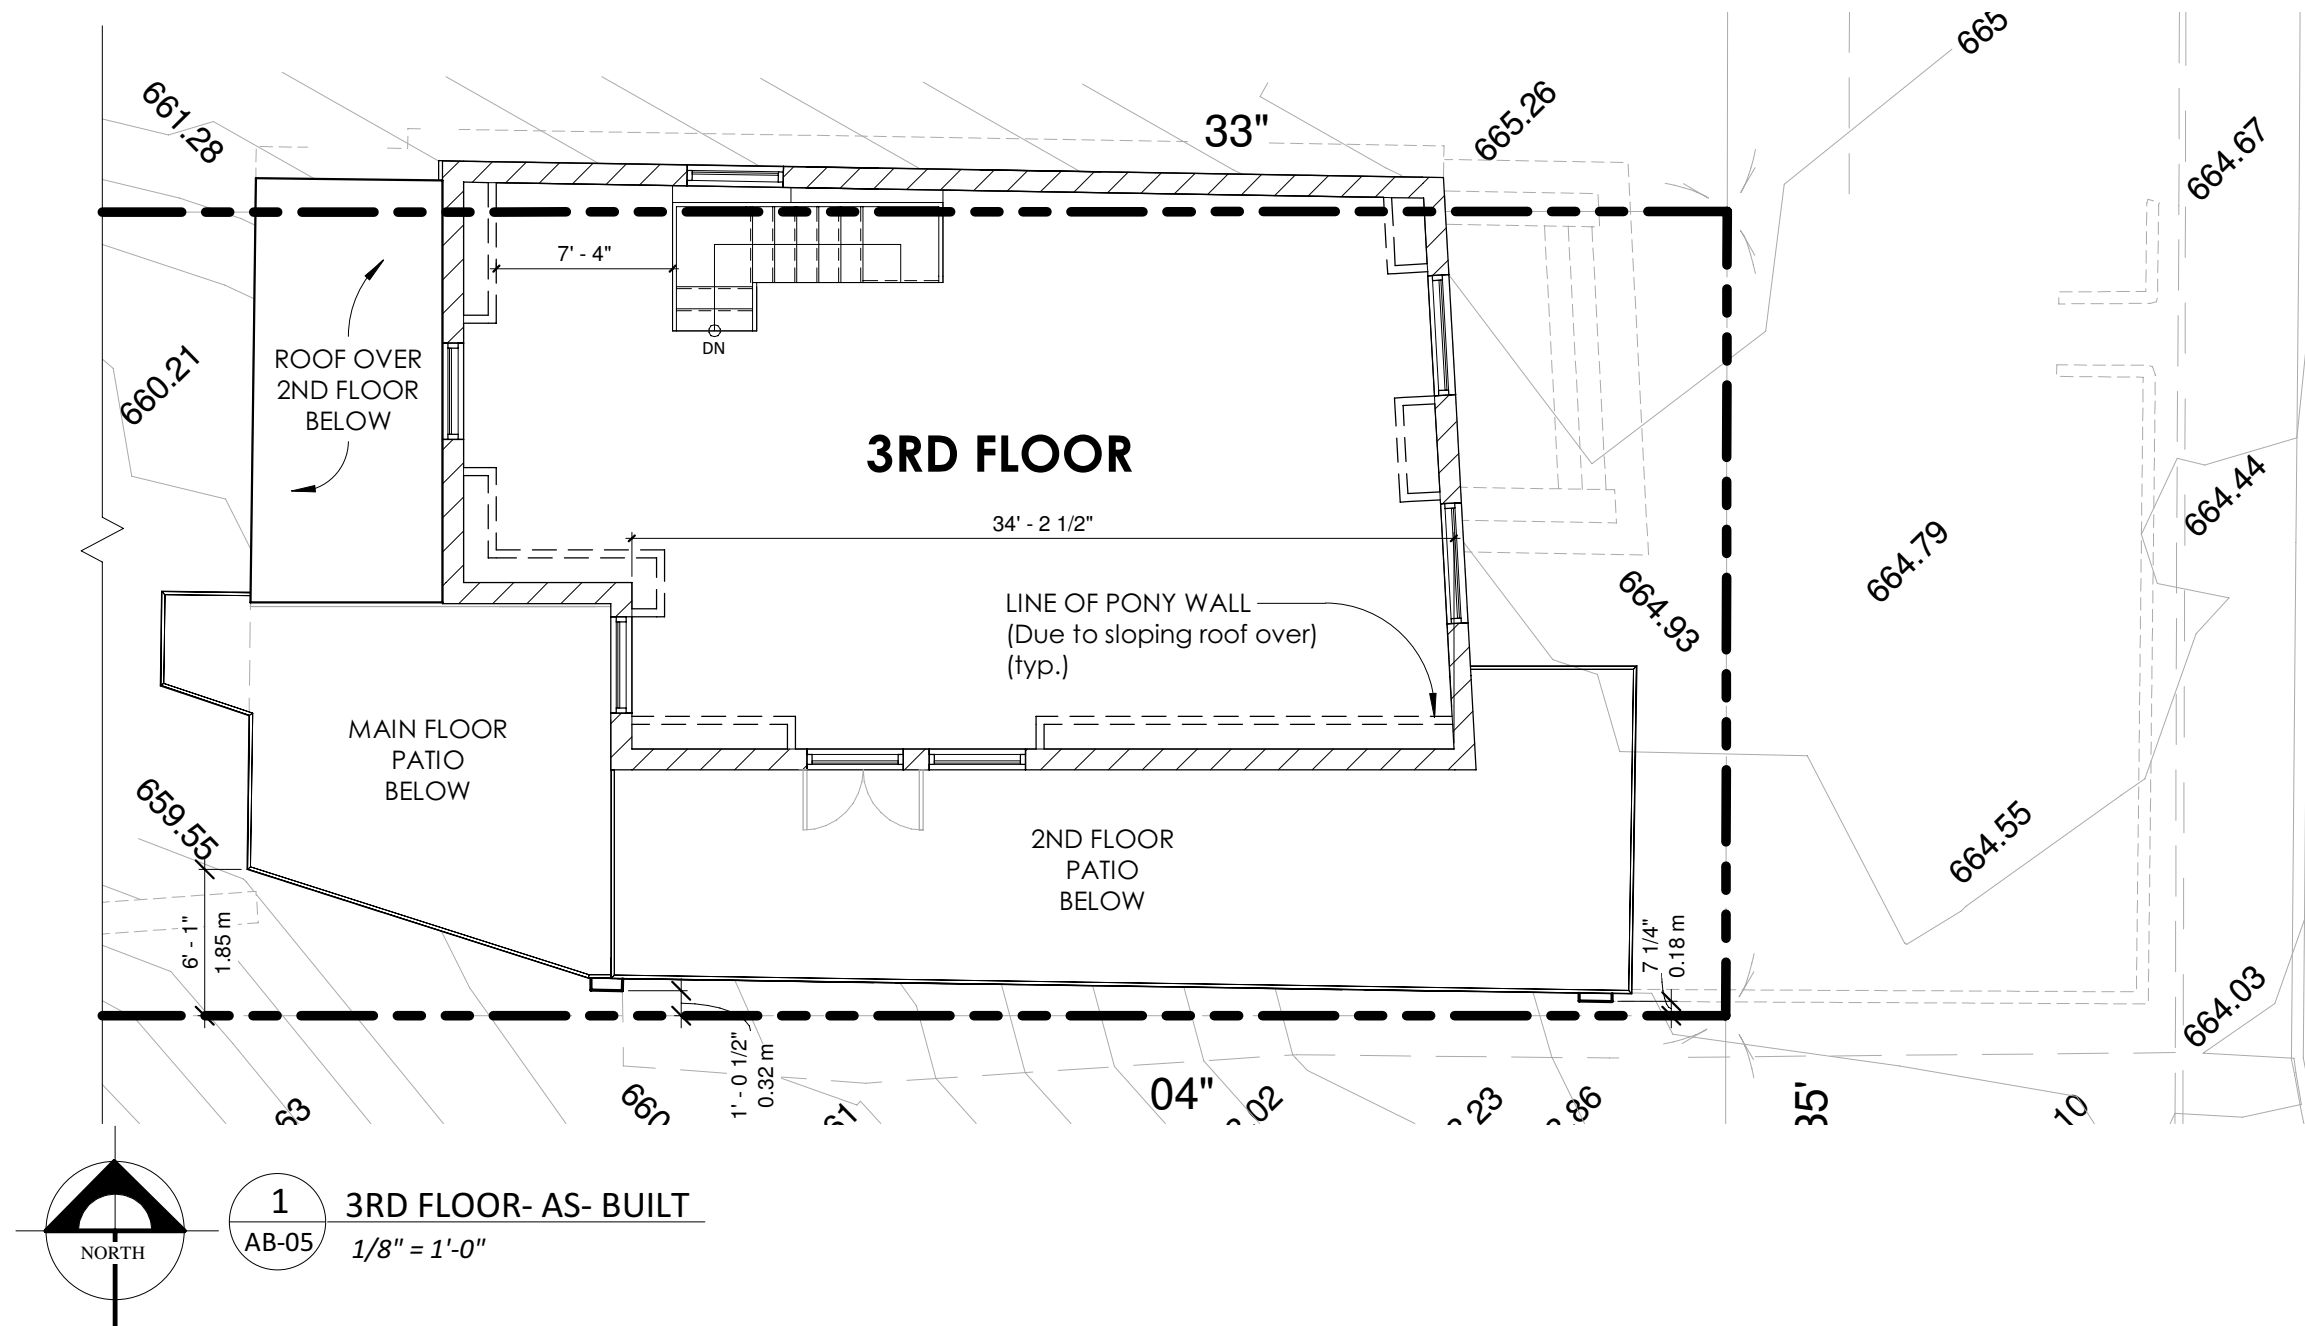

DEVINE PROPERTY

3RD FLOOR- AS BUILT

AB-05

6/12/2020 2:15:21 PM

