


WATERMARK TOWER

530 - 8th AVENUE SW

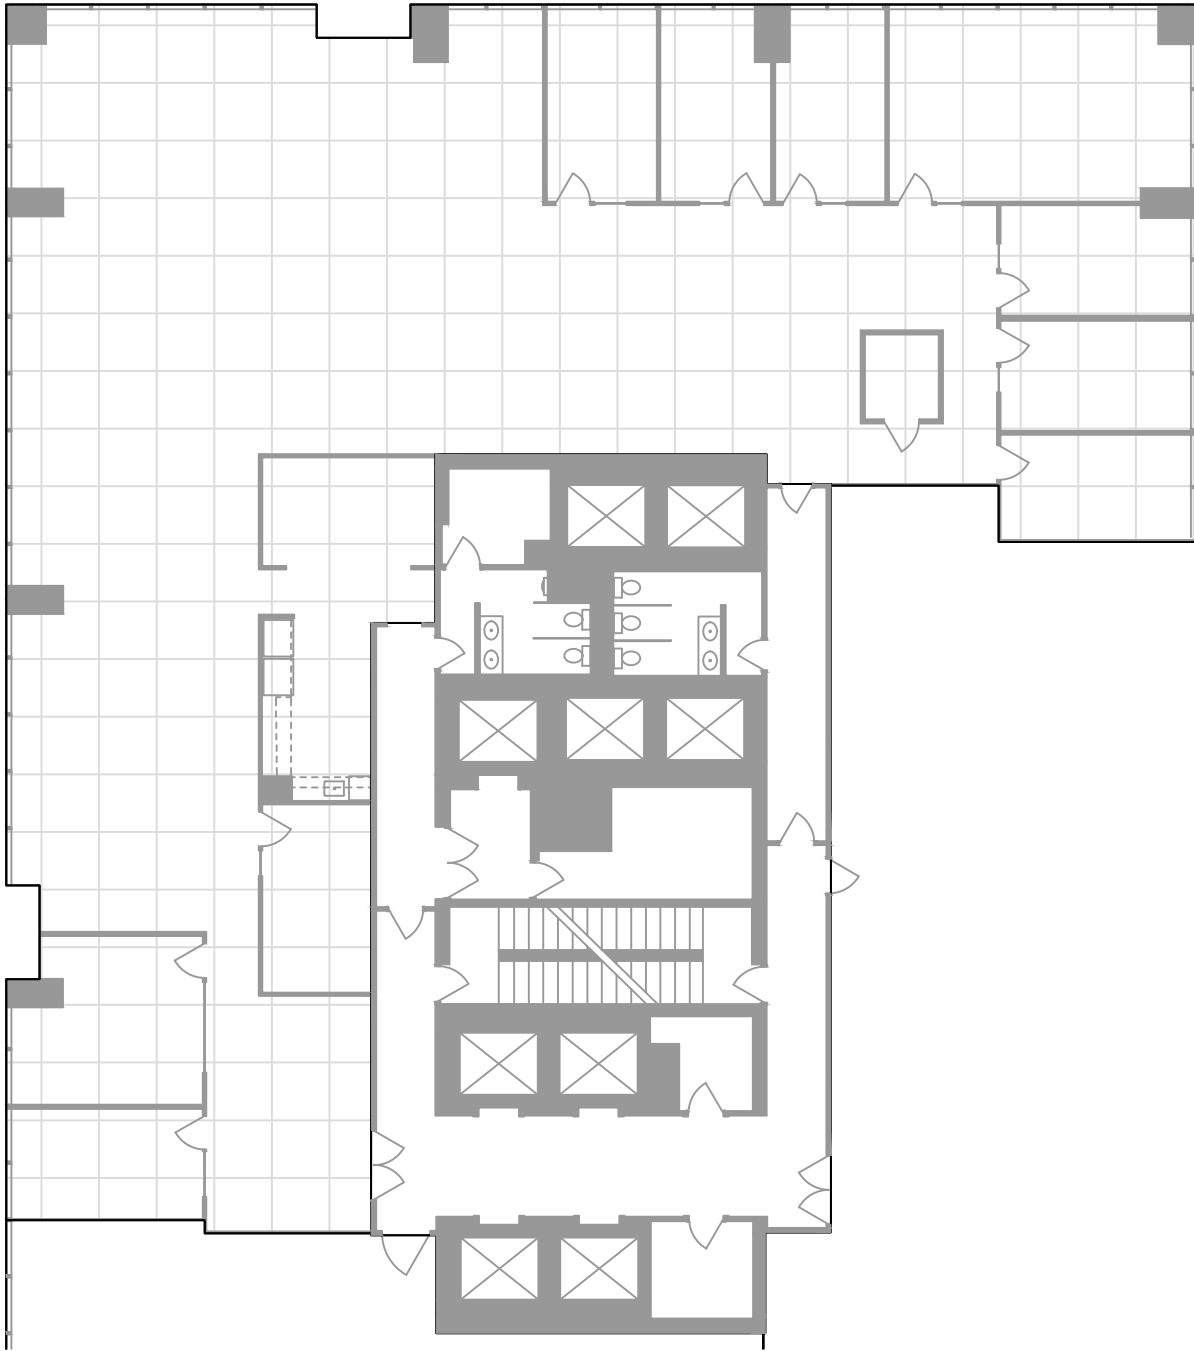

Suite 1220

Rentable Area = 8,050 ft²

Note: Even though obtained from sources deemed reliable, no warranty or representation, express or implied, is made as to the accuracy of the information herein.
Area is based upon BOMA 96 measurements.



McElhanney

Mar. 16/26

Updated As-Built Plan

DJF

DDF

DATE

DESCRIPTION

DRAF

CHKD

Scale: 1:200

PLAN ID.: C25001LS12-1220

REVISIONS

