


SUITE 360E

2487 KALADAR AVENUE, OTTAWA, ON
(AS BUILT FLOOR PLANS)

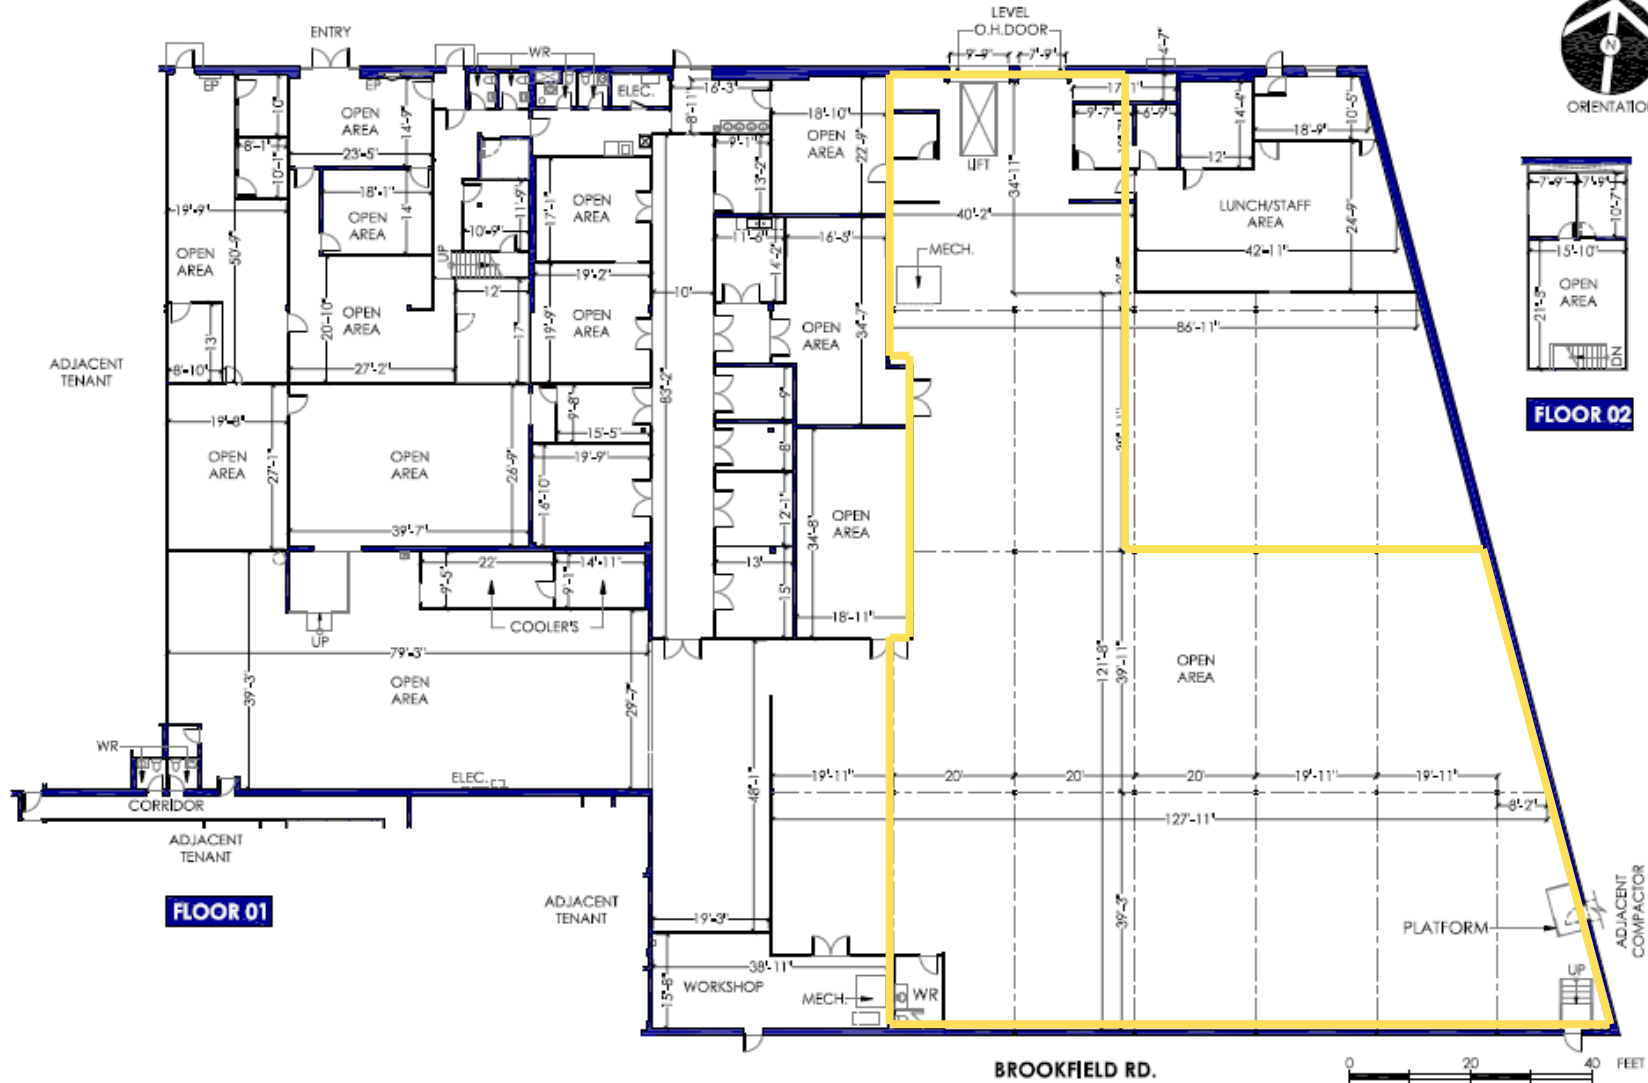

NOTE: SOME AREAS WERE NOT ACCESSIBLE TO MEASUREMENT

0 20 40 FEET
0 6.10 12.19 METRES

PREPARED BY: ECHO FLOOR PLANS.COM

PREPARED FOR: 7902883 Canada Ltd.
ADDRESS: 2487 Kaladar Ave., Ottawa, ON
DATE: October 26, 2011
REVISION: November 21, 2011
PROJECT NUMBER: 100302
DRAWING SIZE: 8.5' x 14' - Legal Size

ECHO FLOOR PLANS
• As-Built Floor Plans
• Area Analysis
• Space Planning
www.EchoFloorPlans.com