

CONCERT® PROPERTIES



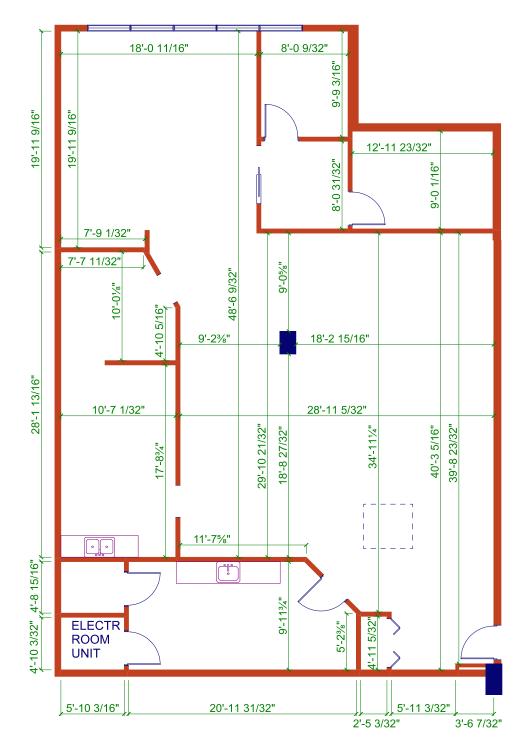

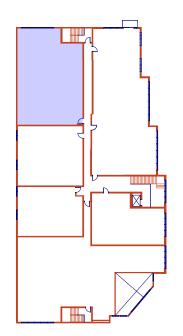

APRIL 11, 2025

SCALE: AS NOTED

CLIENT:

PROJECT No.:

DRAWING No.:

WILLOWBROOK BUSINESS PARK BUILDING 300 6325 204th AVENUE LANGLEY, BC
SUITE 320
DRAWING TITLE: DETAILED PLAN



CALGARY: (403) 861-4692 VANCOUVER: (778) 786-2000 WEBSITE: www.accuspacemeasuring.com

REVISIONS:

3JAN24 - D.O. - AS-BUILT DRAWINGS PRODUCED

11APR25 - A.N. - DETAILED SUITE PLAN FOR SUITE 320 PRODUCED.