


5th & 5th

605 - 5th AVENUE SW

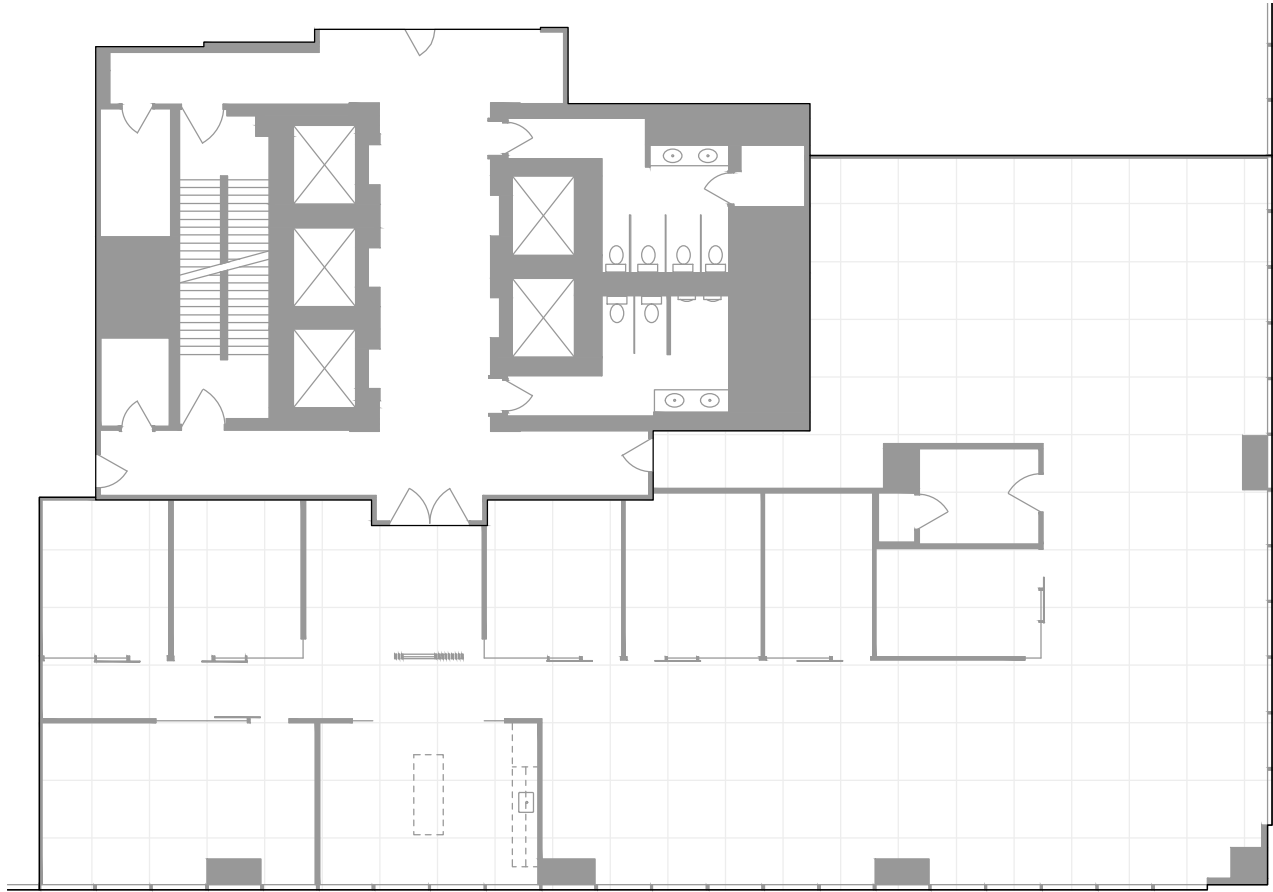

Suite 2810

Rentable Area = 5,970 ft²

**Even though obtained from sources deemed reliable, no warranty or representation, express or implied, is made as to the accuracy of the information herein.



McElhanney

Oct. 10/25	Updated As-Built	DJF	DDF
DATE	DESCRIPTION	DRAF	CHKD

REVISIONS

Scale: 1:200 | PLAN ID.: 331125002ASB28-2810

