

TD TOWER

As-Built Space Plans




CITY CENTRE
TOWERS

TD Tower

FLOORPLAN
SUITE 901 - 14,513 SF



CITY CENTRE
TOWERS

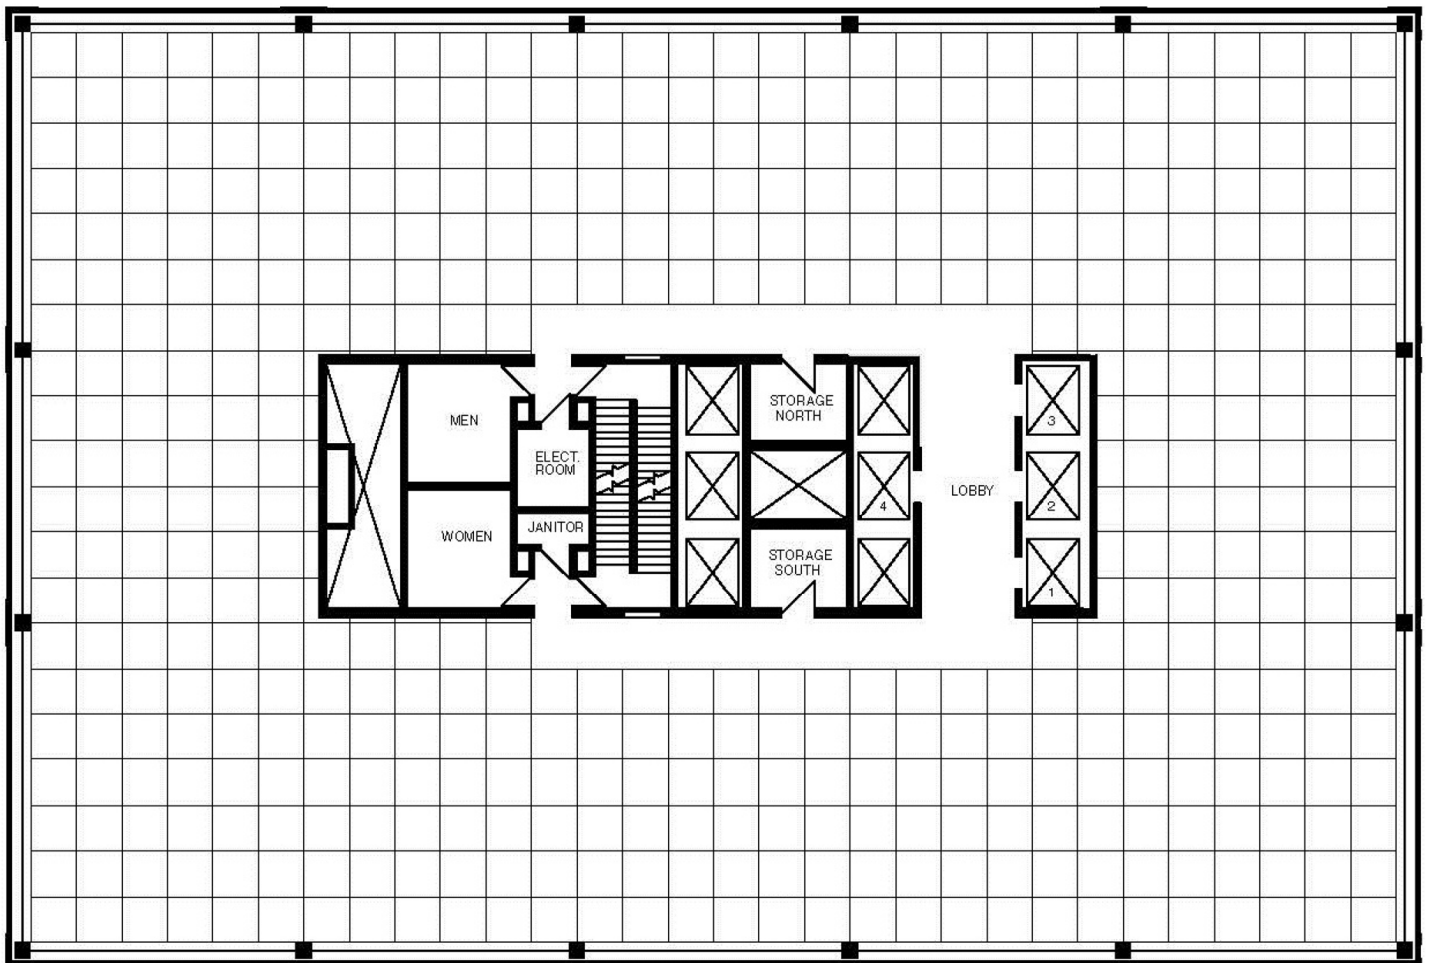

TD Tower

FLOORPLAN
SUITE 1101 - 11,593 SF



CITY CENTRE
TOWERS


COMING SOON

TD Tower

FLOORPLAN
SUITE 1205 - 3,662 SF



CITY CENTRE
TOWERS

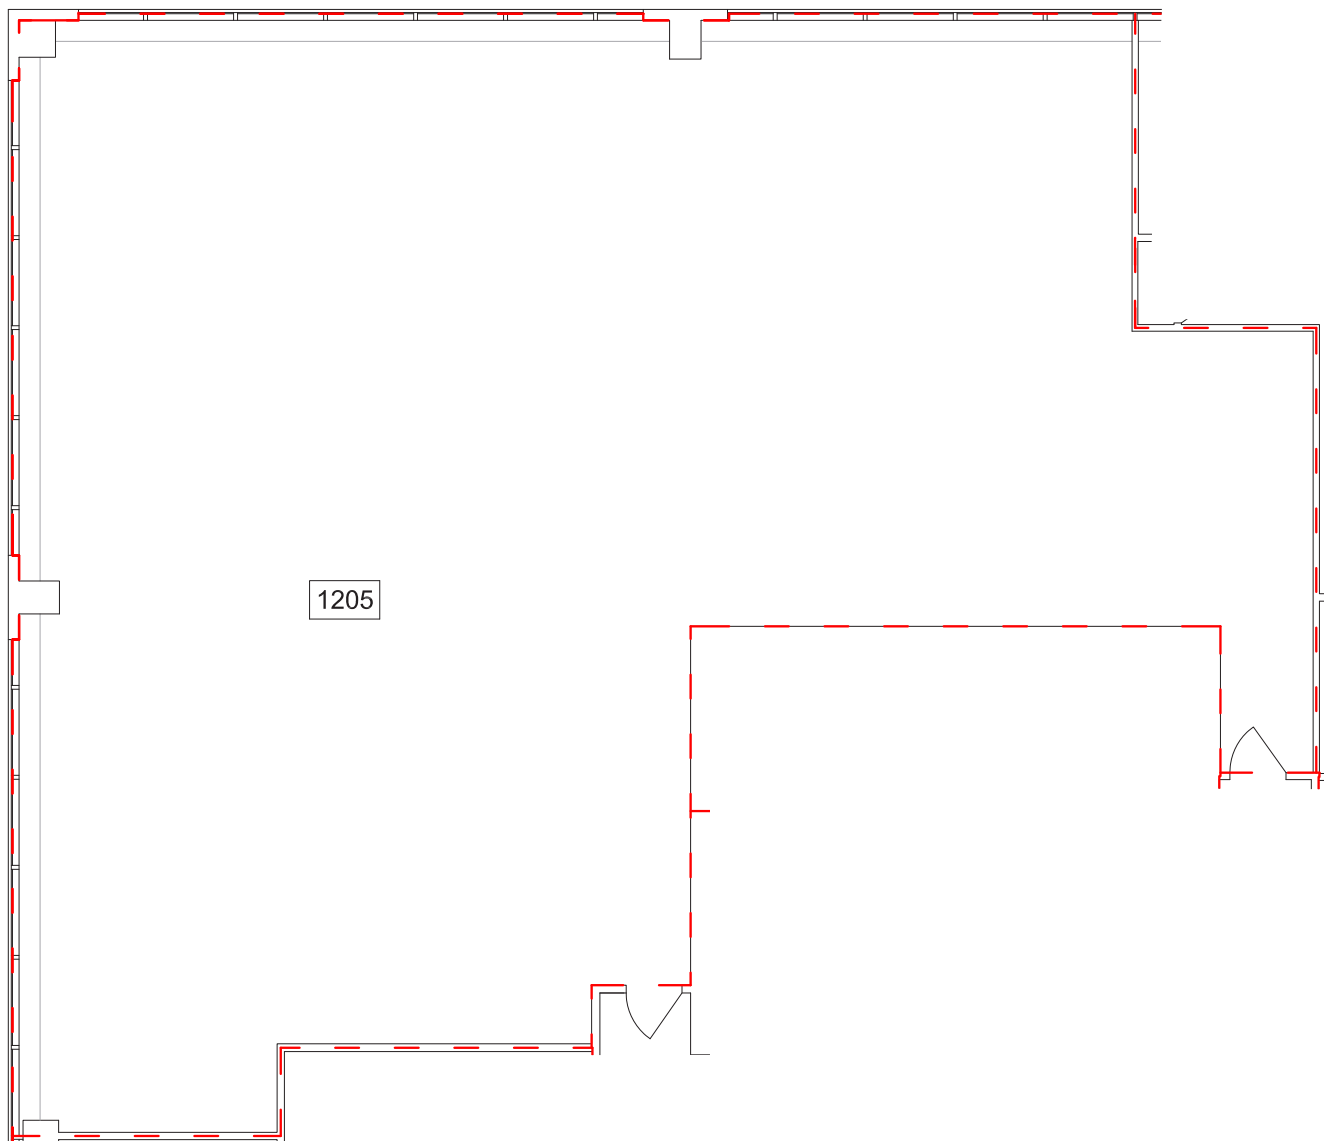


[View Suite Photos](#)

TD Tower

FLOORPLAN
SUITE 1407 - 2,994 SF



CITY CENTRE
TOWERS

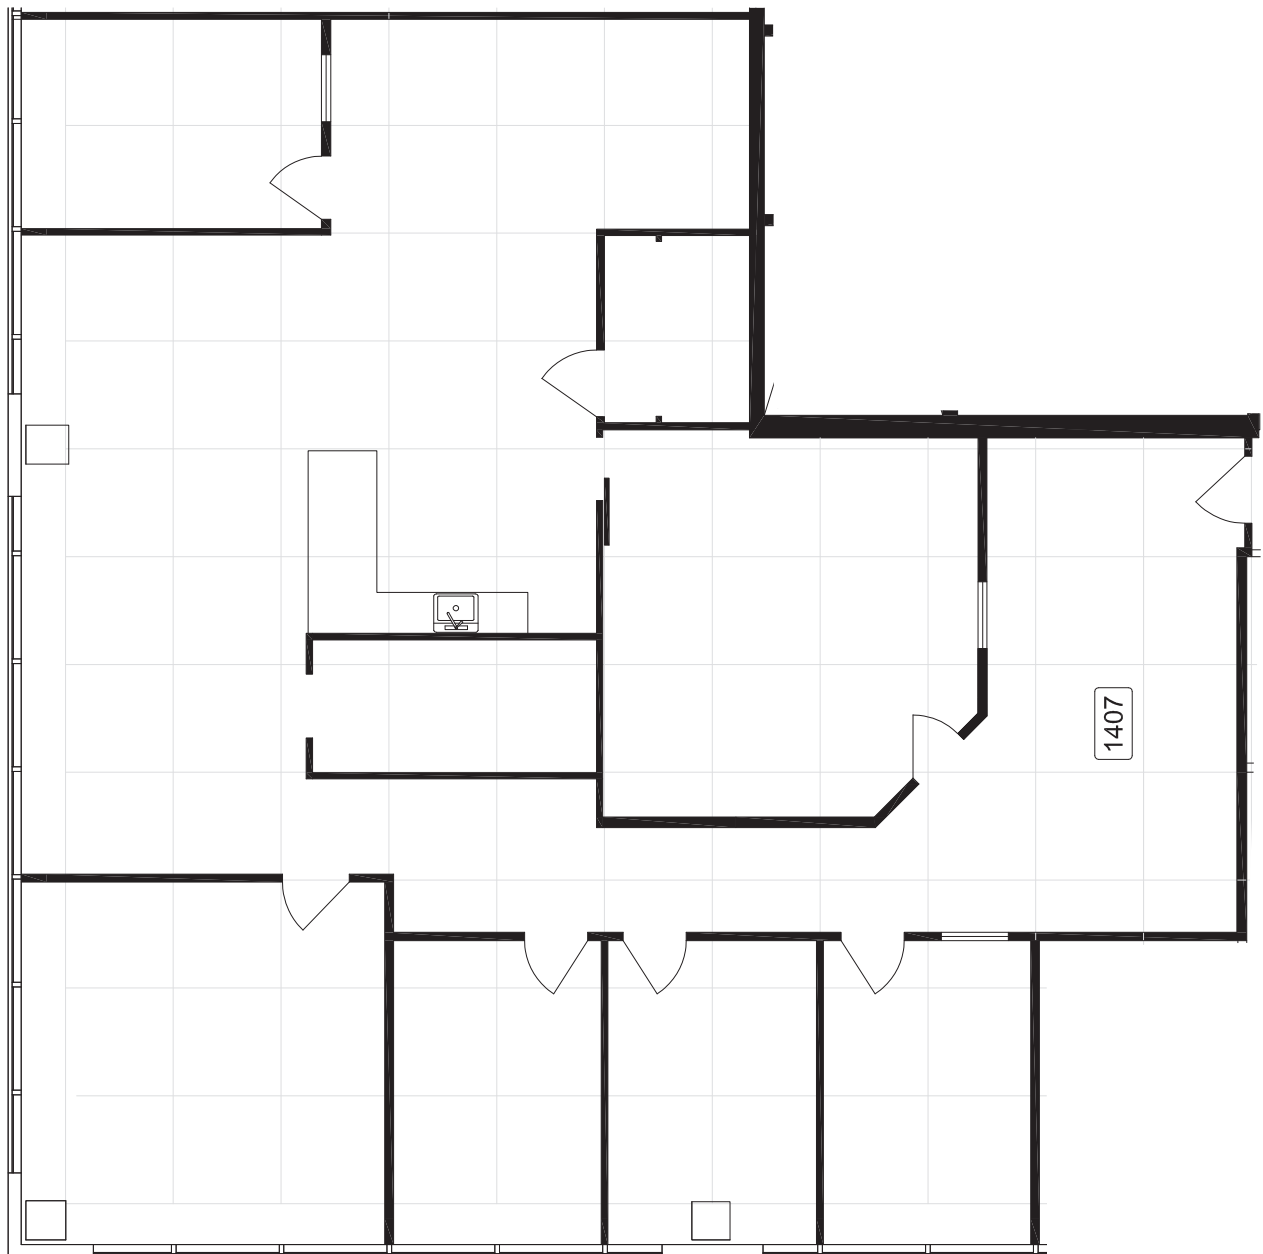


TD Tower

FLOORPLAN
SUITE 1409 - 891 SF



CITY CENTRE
TOWERS

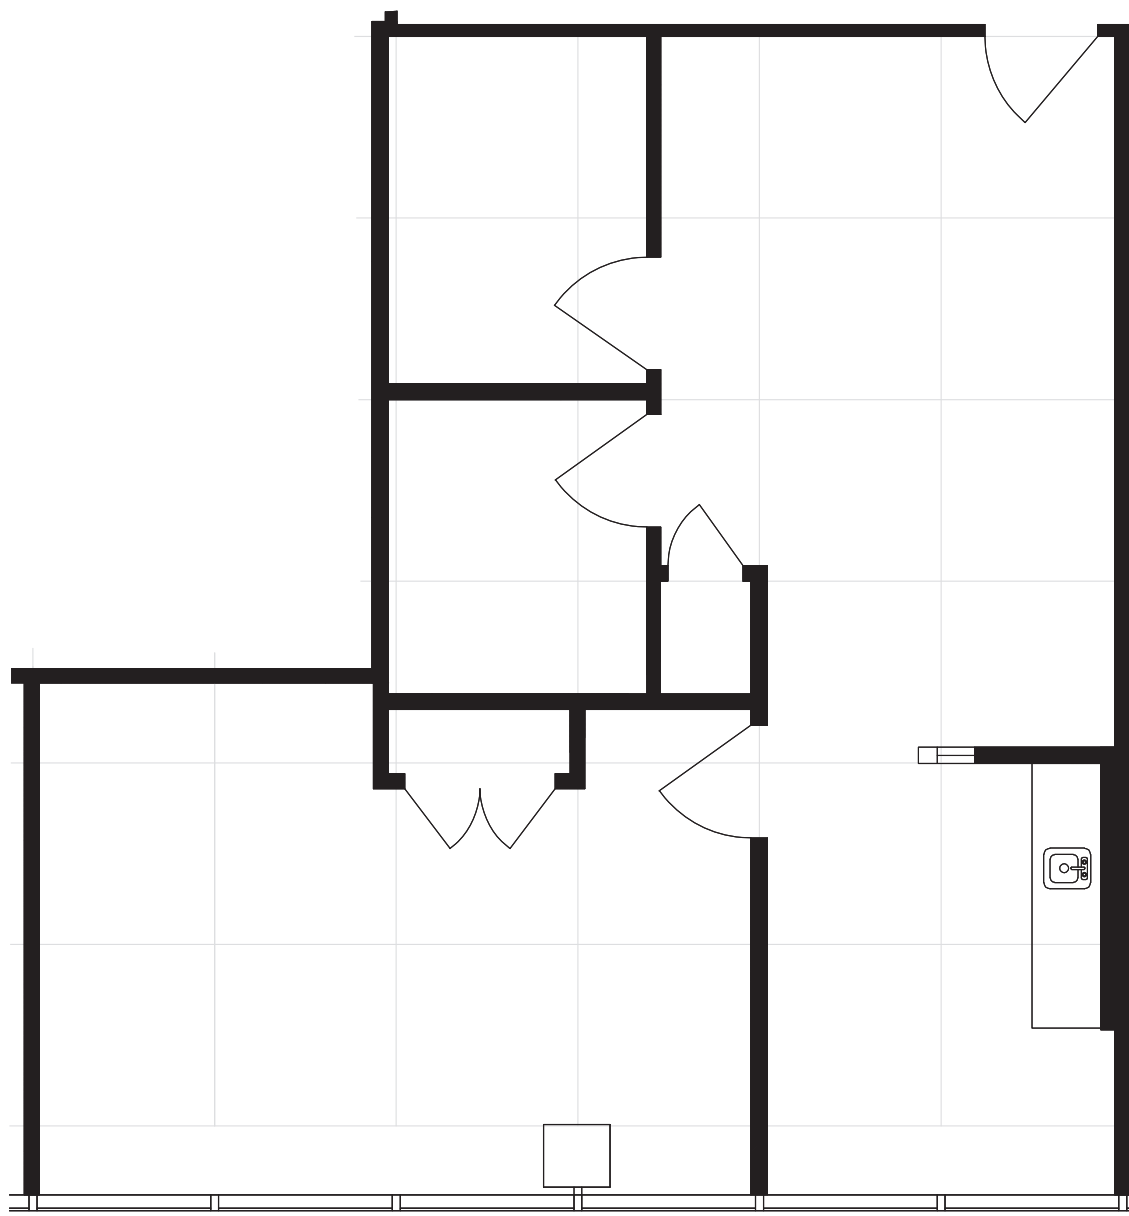


[View Suite Photos](#)

TD Tower

FLOORPLAN
SUITE 1500 - 14,822 SF



CITY CENTRE
TOWERS

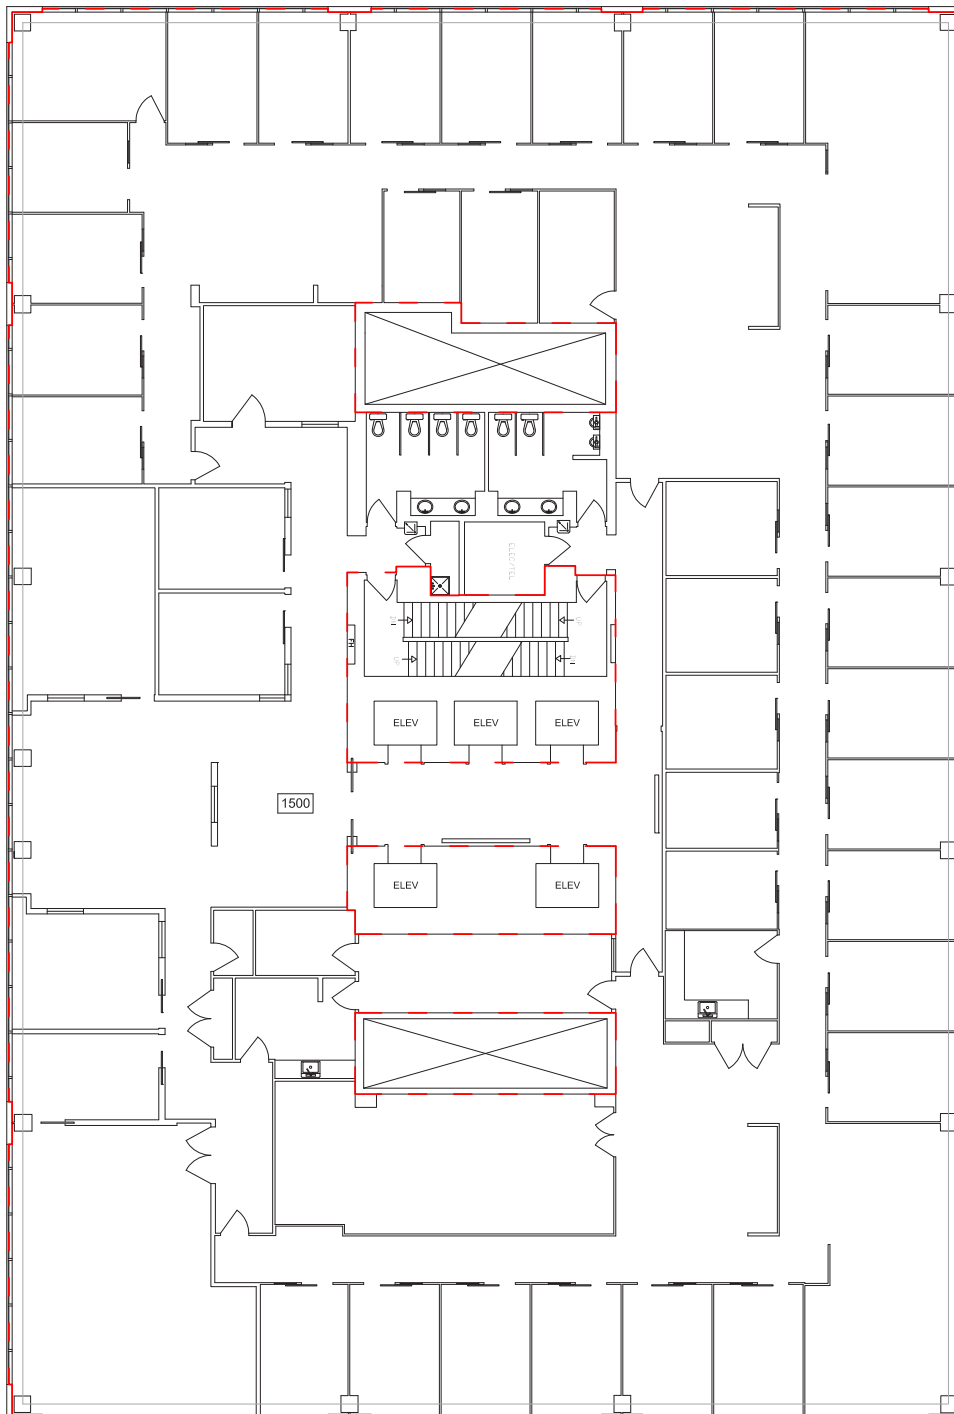


TD Tower

FLOORPLAN
SUITE 1601 - 14,613 SF



CITY CENTRE
TOWERS

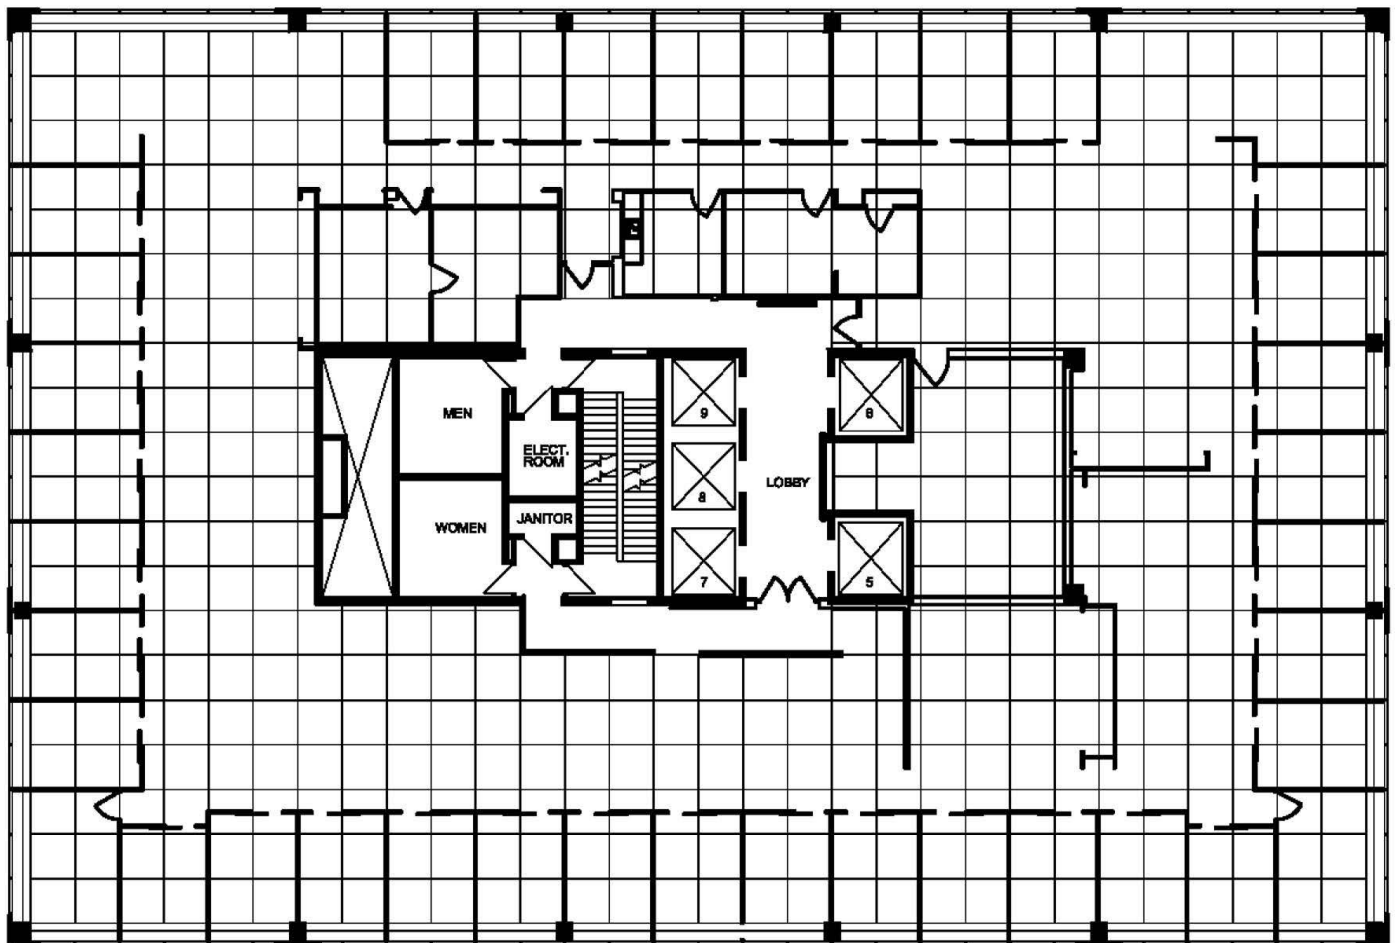


TD Tower

FLOORPLAN
SUITE 1705 - 2,560 SF



CITY CENTRE
TOWERS

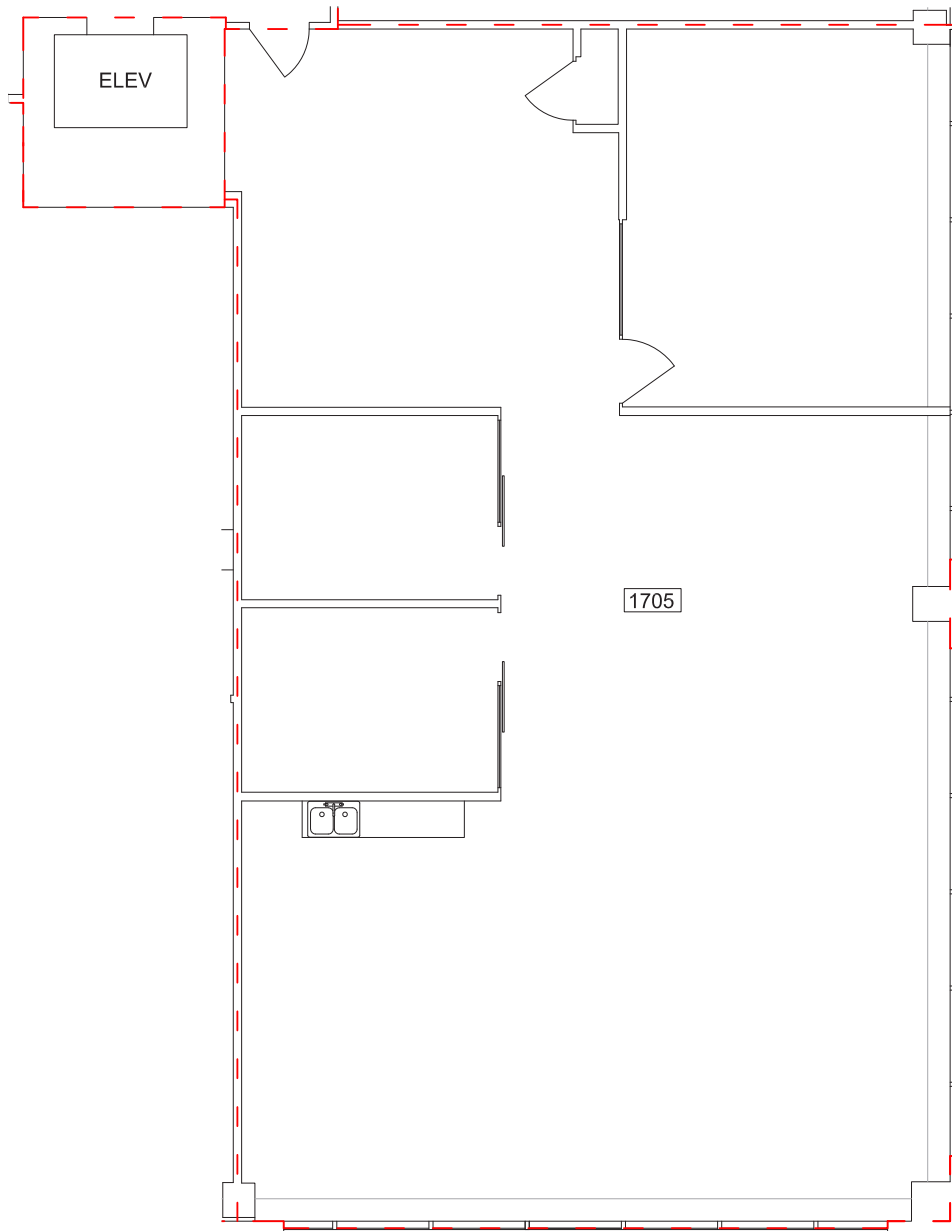


[View Suite Photos](#)

TD Tower

FLOORPLAN
SUITE 2107 - 2,418 SF



CITY CENTRE
TOWERS

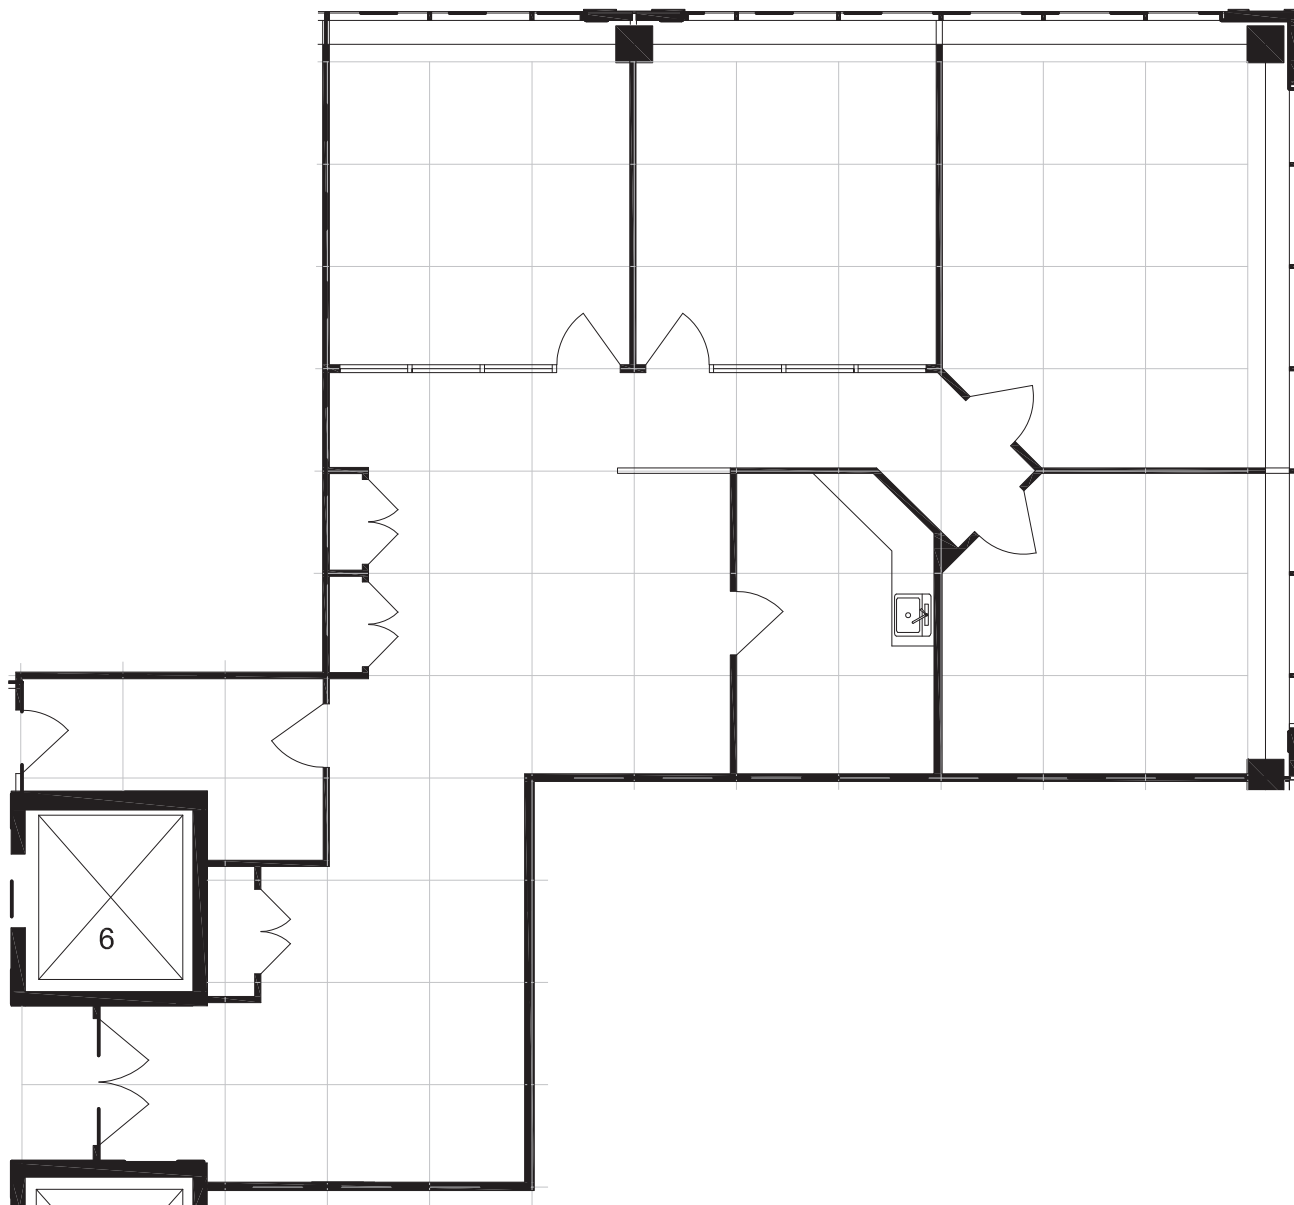

TD Tower

FLOORPLAN

SUITE 2507 B - ±1,200 SF



CITY CENTRE
TOWERS

COMING SOON

TD TOWER

Conceptual Space Plans




CITY CENTRE
TOWERS

TD Tower

CONCEPTUAL PLAN
SUITE 1205 - 3,662 SF



CITY CENTRE
TOWERS

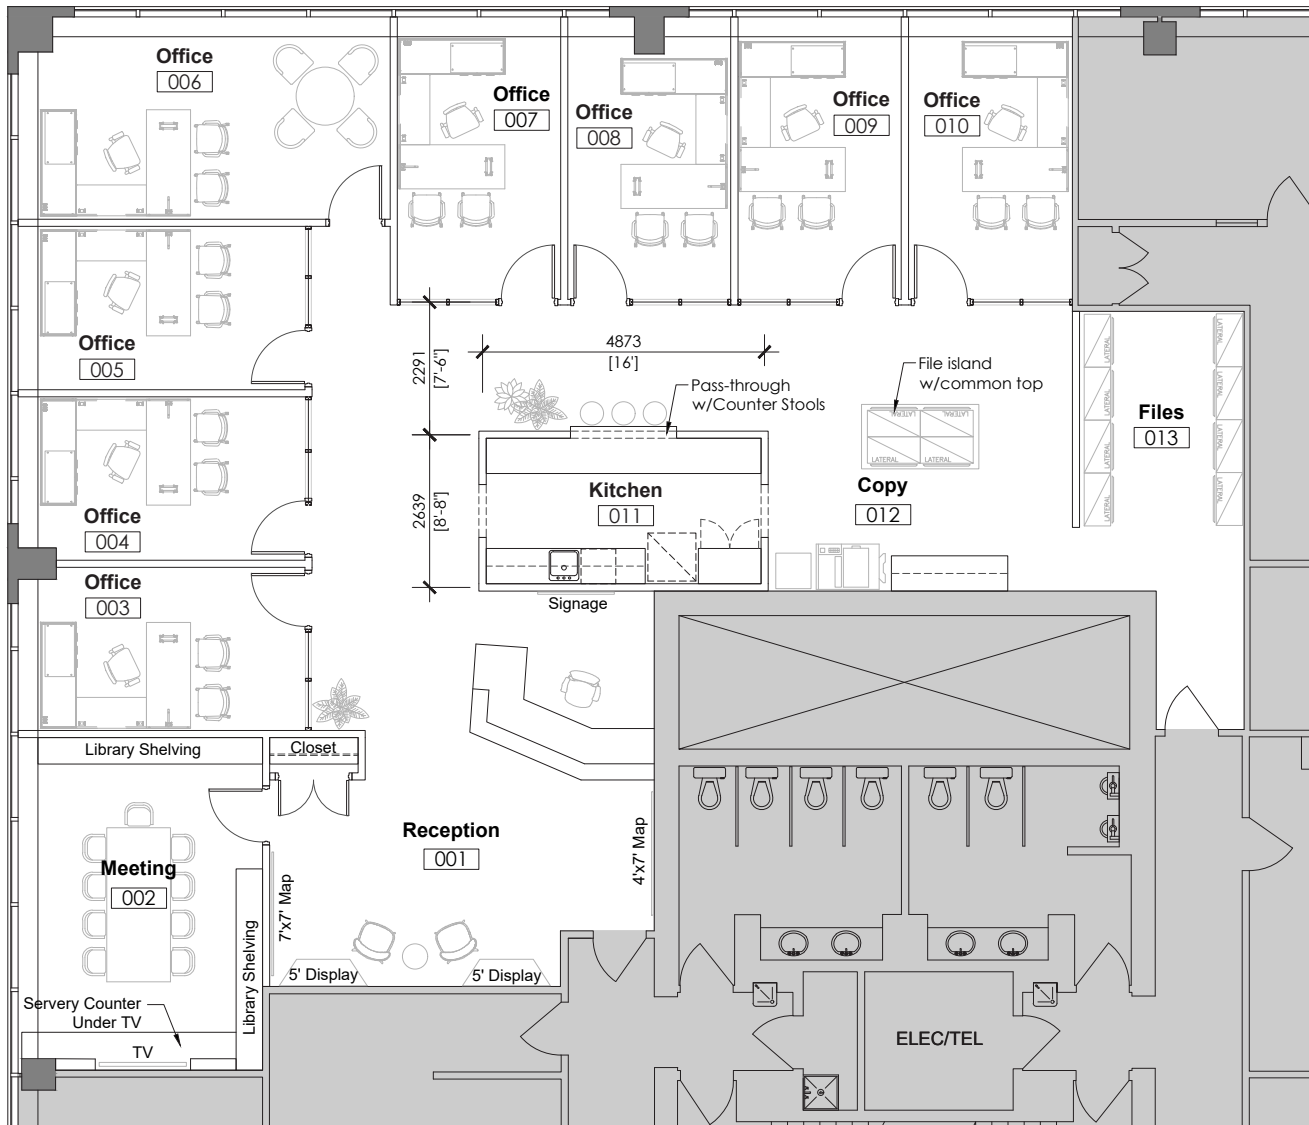

TD Tower

CONCEPTUAL PLAN
FULL FLOOR - OFFICE INTENSIVE



CITY CENTRE
TOWERS

