



5th & 5th
605 - 5th AVENUE SW

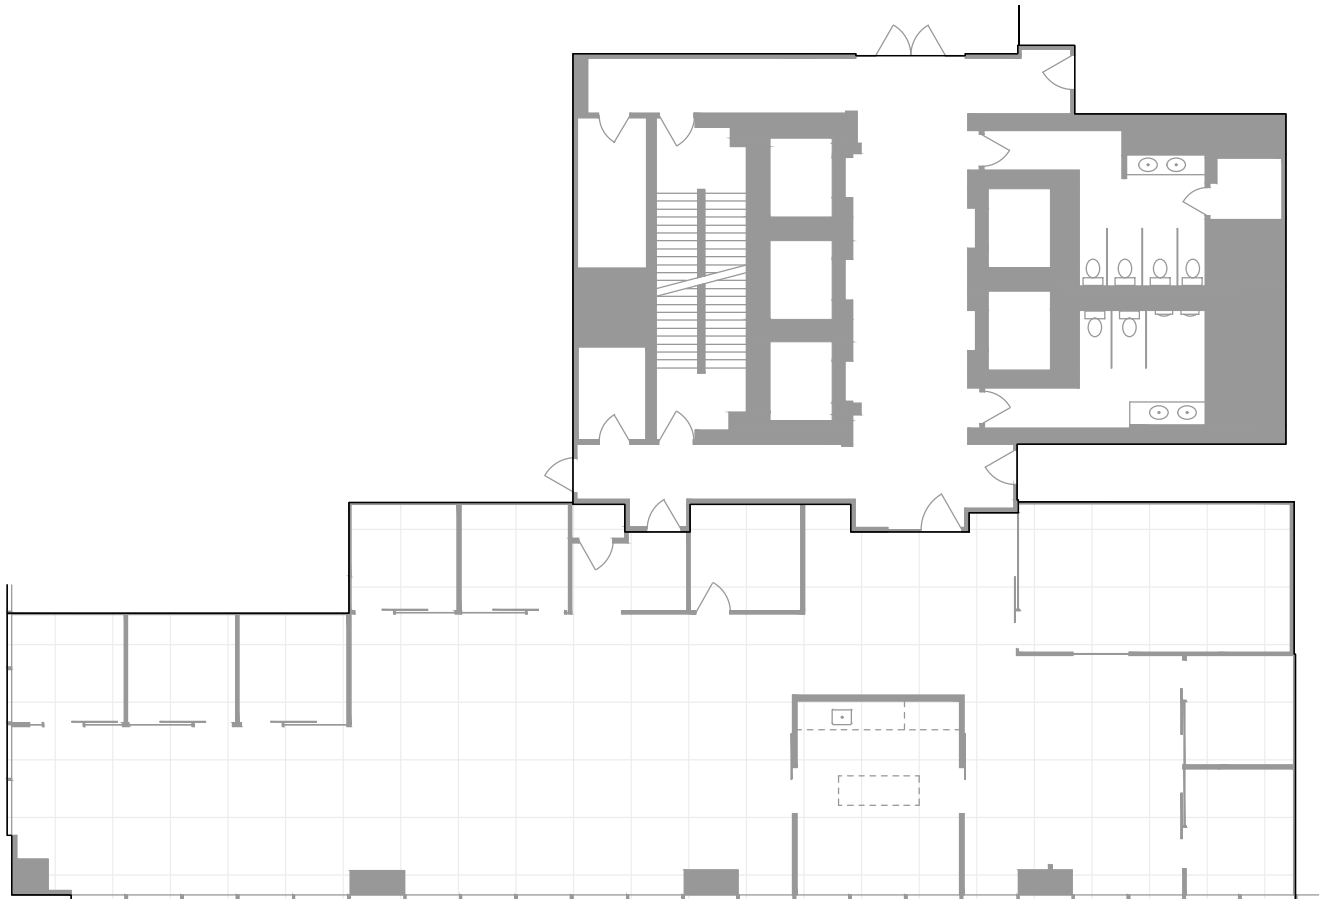

Suite 2520

Rentable Area = 4,296 ft²

Note: Even though obtained from sources deemed reliable, no warranty or representation, express or implied, is made as to the accuracy of the information herein. Area is based upon BOMA 96 measurements.

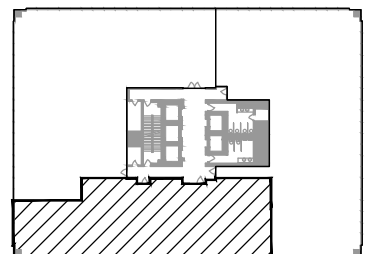

	1	Jun. 6/24	Updated As-Built Plan	DJF	DDF
	REV.	DATE	DESCRIPTION	DRAF	CHKD
REVISIONS					

Scale: 1:200 | PLAN ID.: C25002LS25-2520