
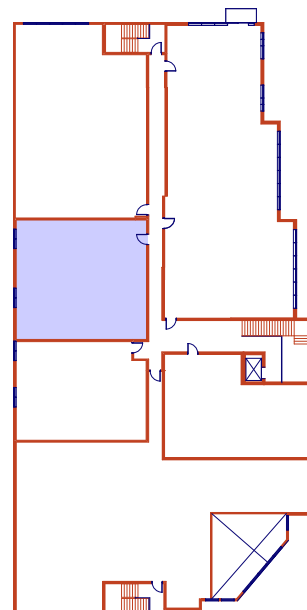


DRAWING TITLE:
DETAILED PLAN

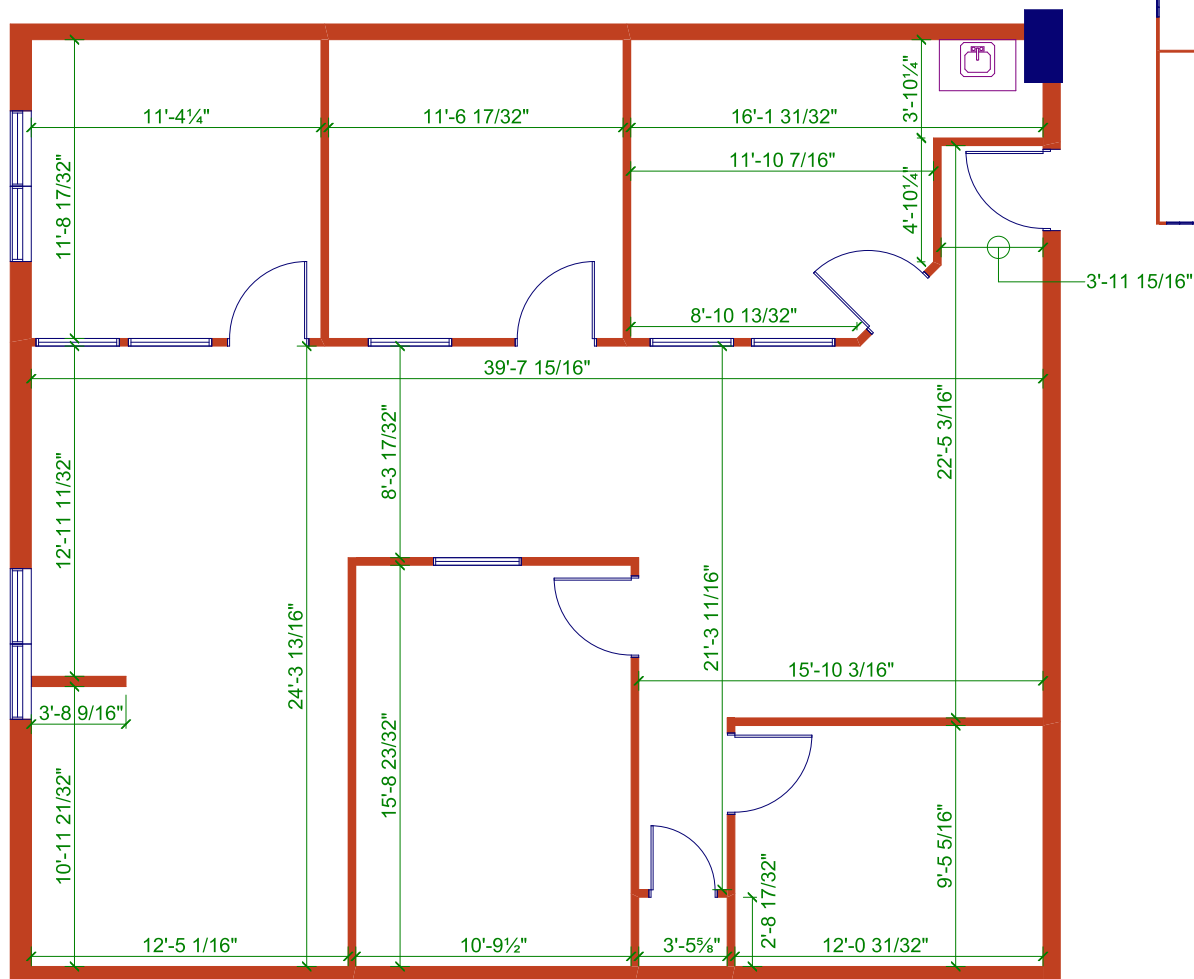

3JAN24 - D.O. - AS-BUILT DRAWINGS PRODUCED