

102A TOWER

As-Built Space Plans




CITY CENTRE
TOWERS

102A Tower

FLOORPLAN
5TH FLOOR - 11,779 SF



CITY CENTRE
TOWERS

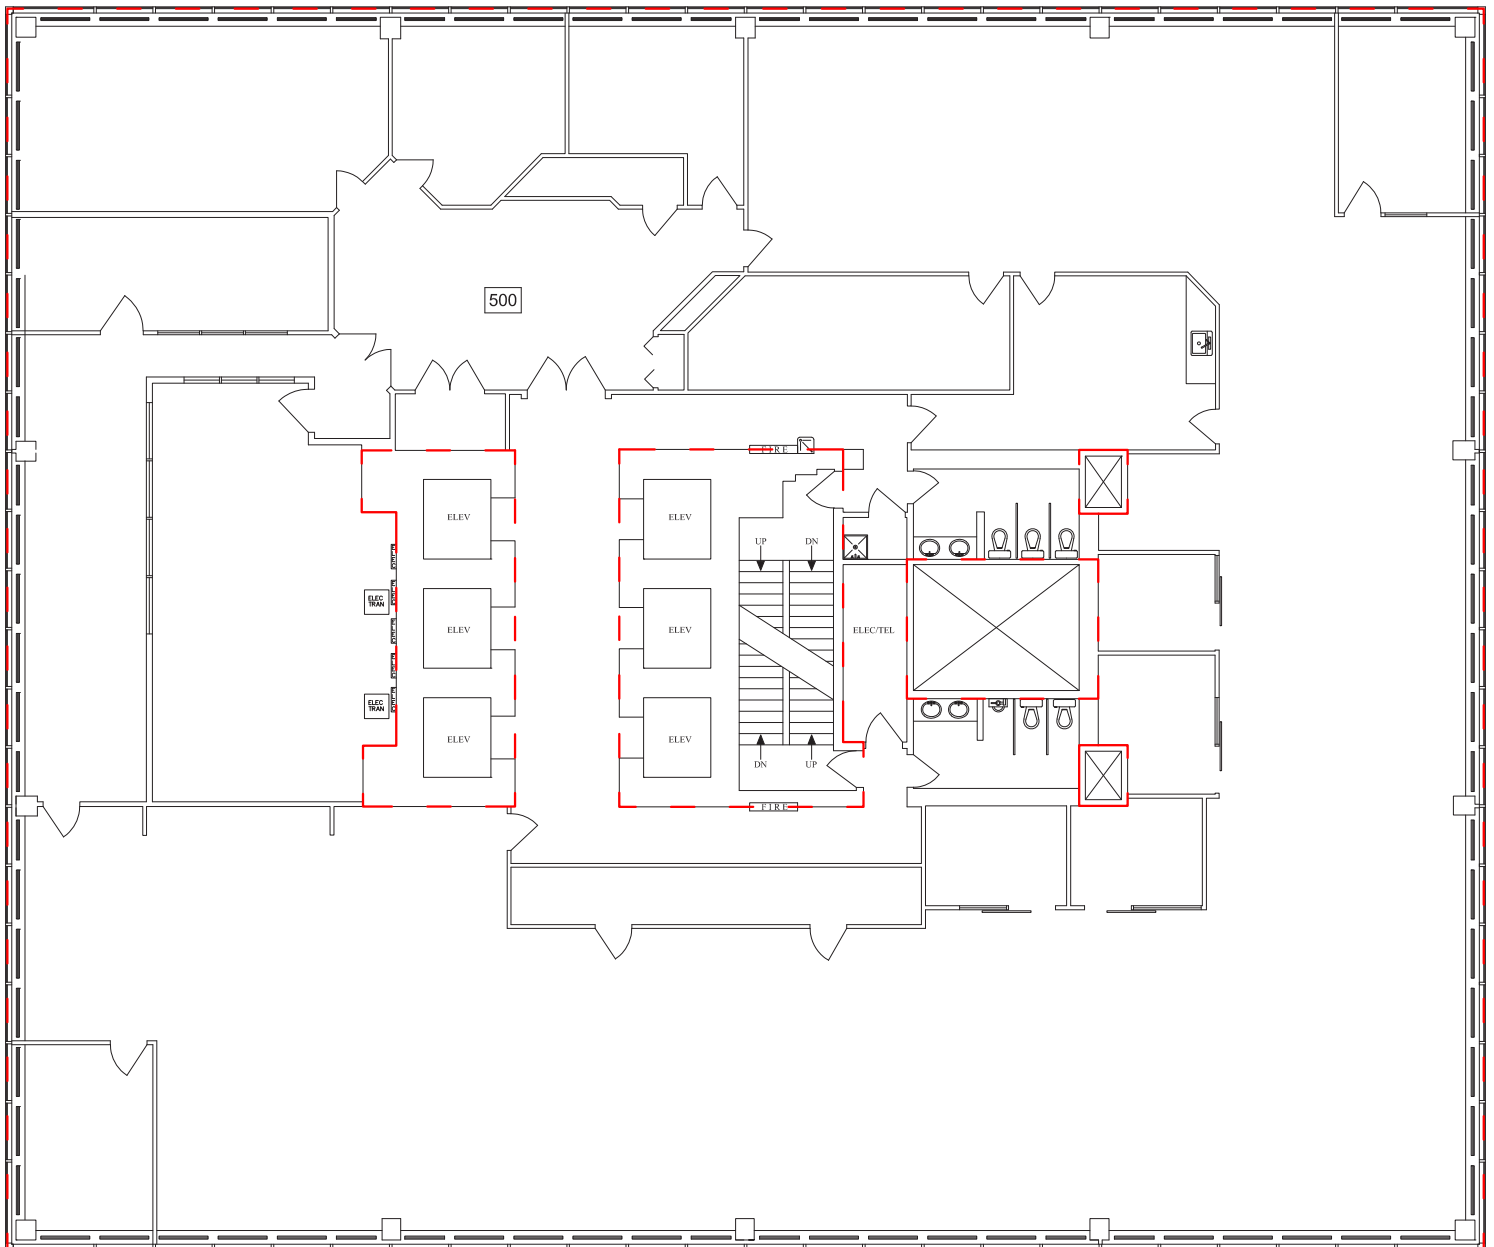


102A Tower

FLOORPLAN
6TH FLOOR - 11,814 SF



CITY CENTRE
TOWERS

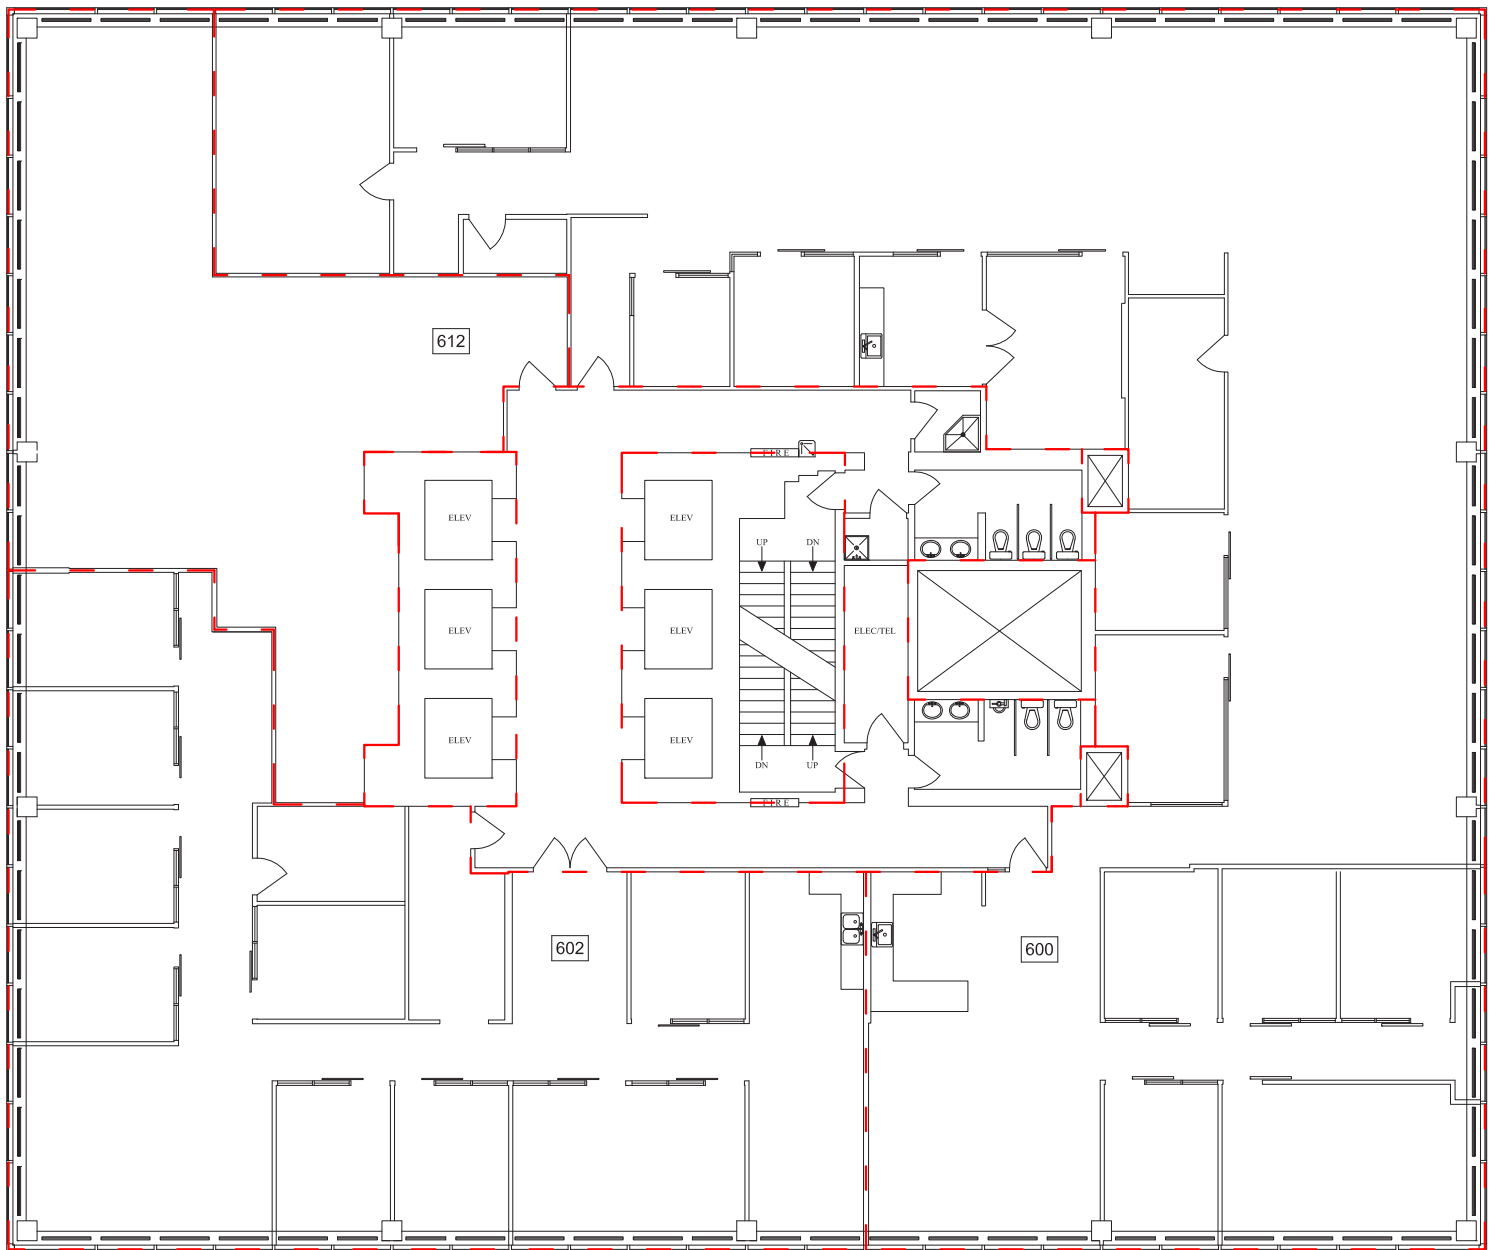


102A Tower

FLOORPLAN
7TH FLOOR - 11,809 SF



CITY CENTRE
TOWERS

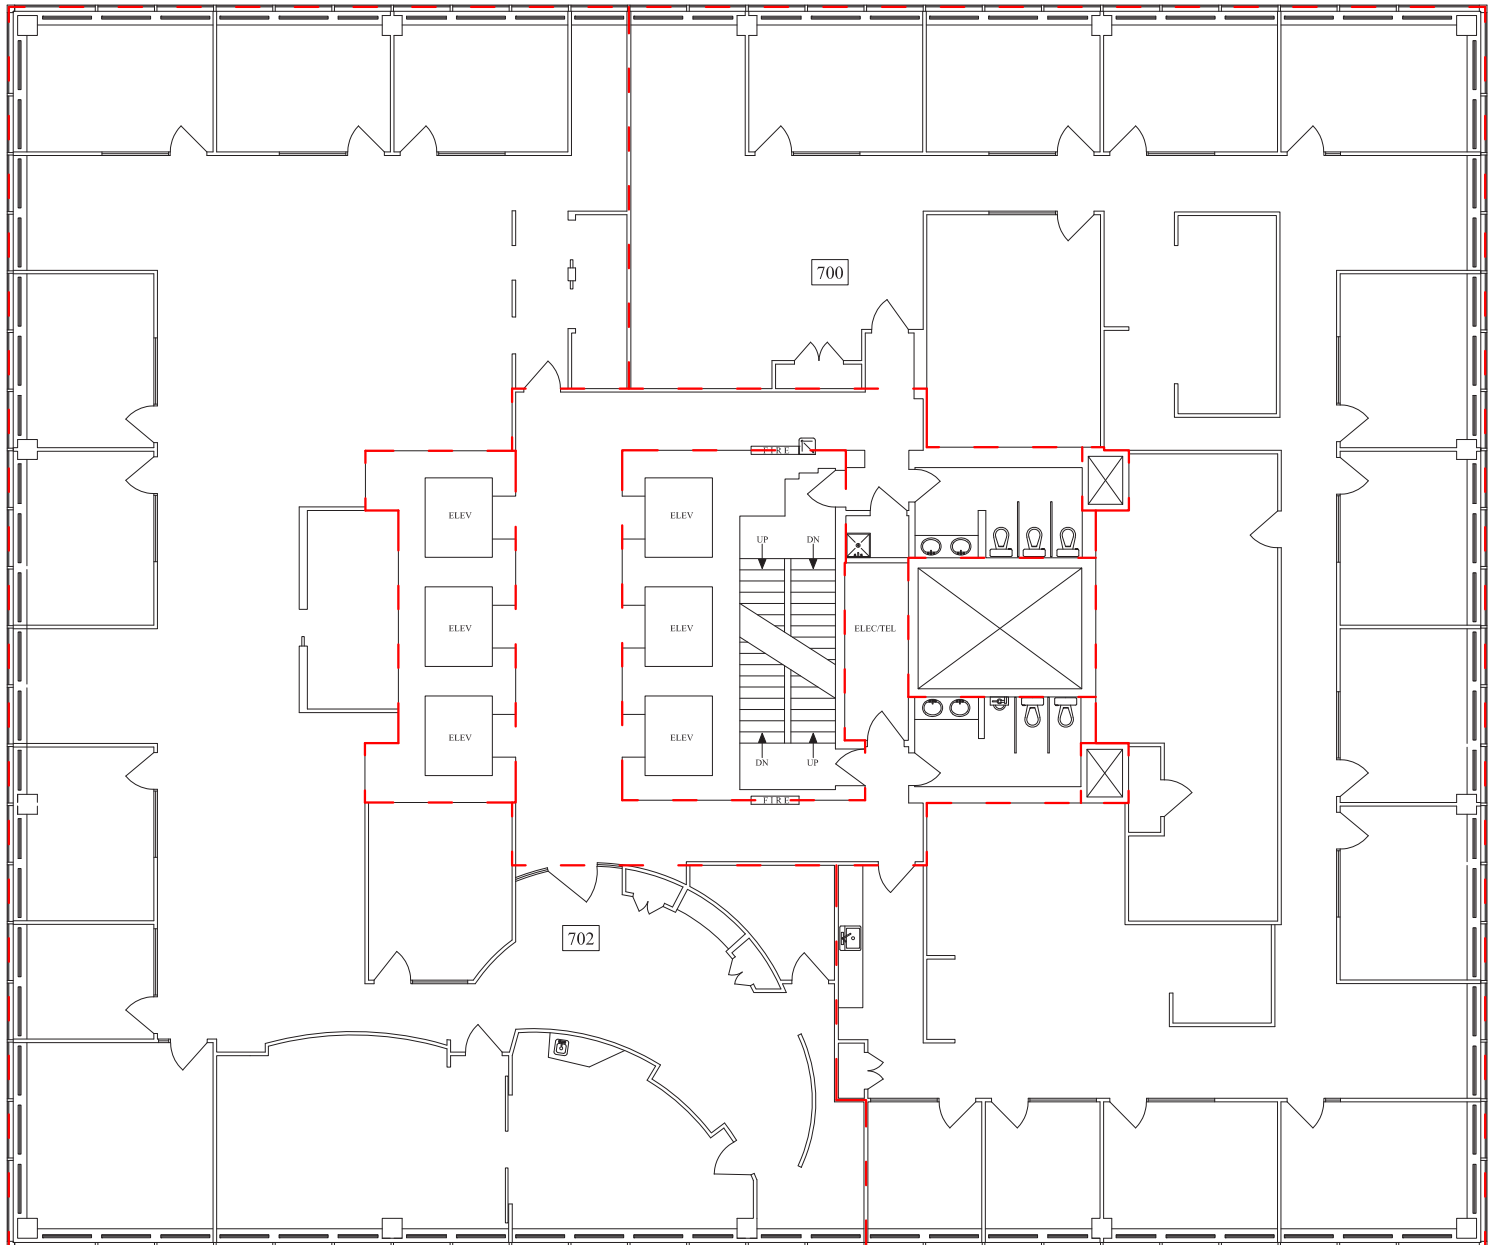


102A Tower

FLOORPLAN
8TH FLOOR - 11,805 SF



CITY CENTRE
TOWERS

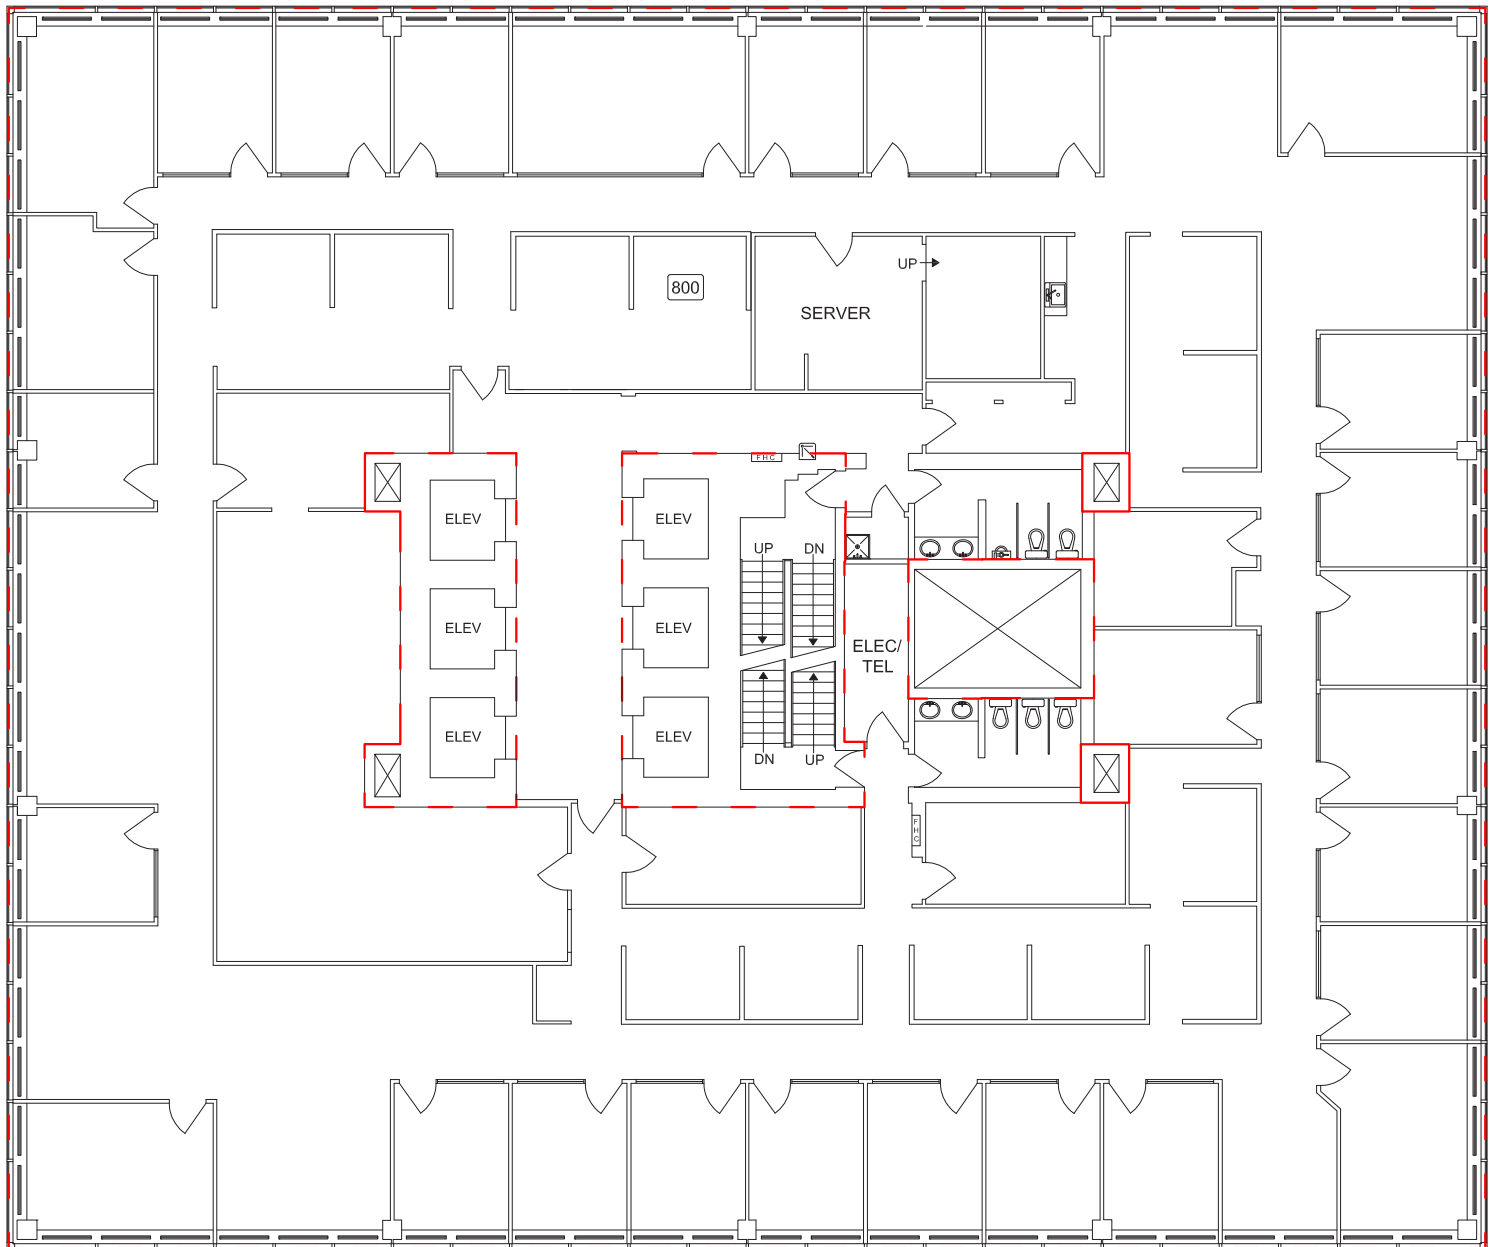


102A Tower

FLOORPLAN
9TH FLOOR - 11,811 SF



CITY CENTRE
TOWERS

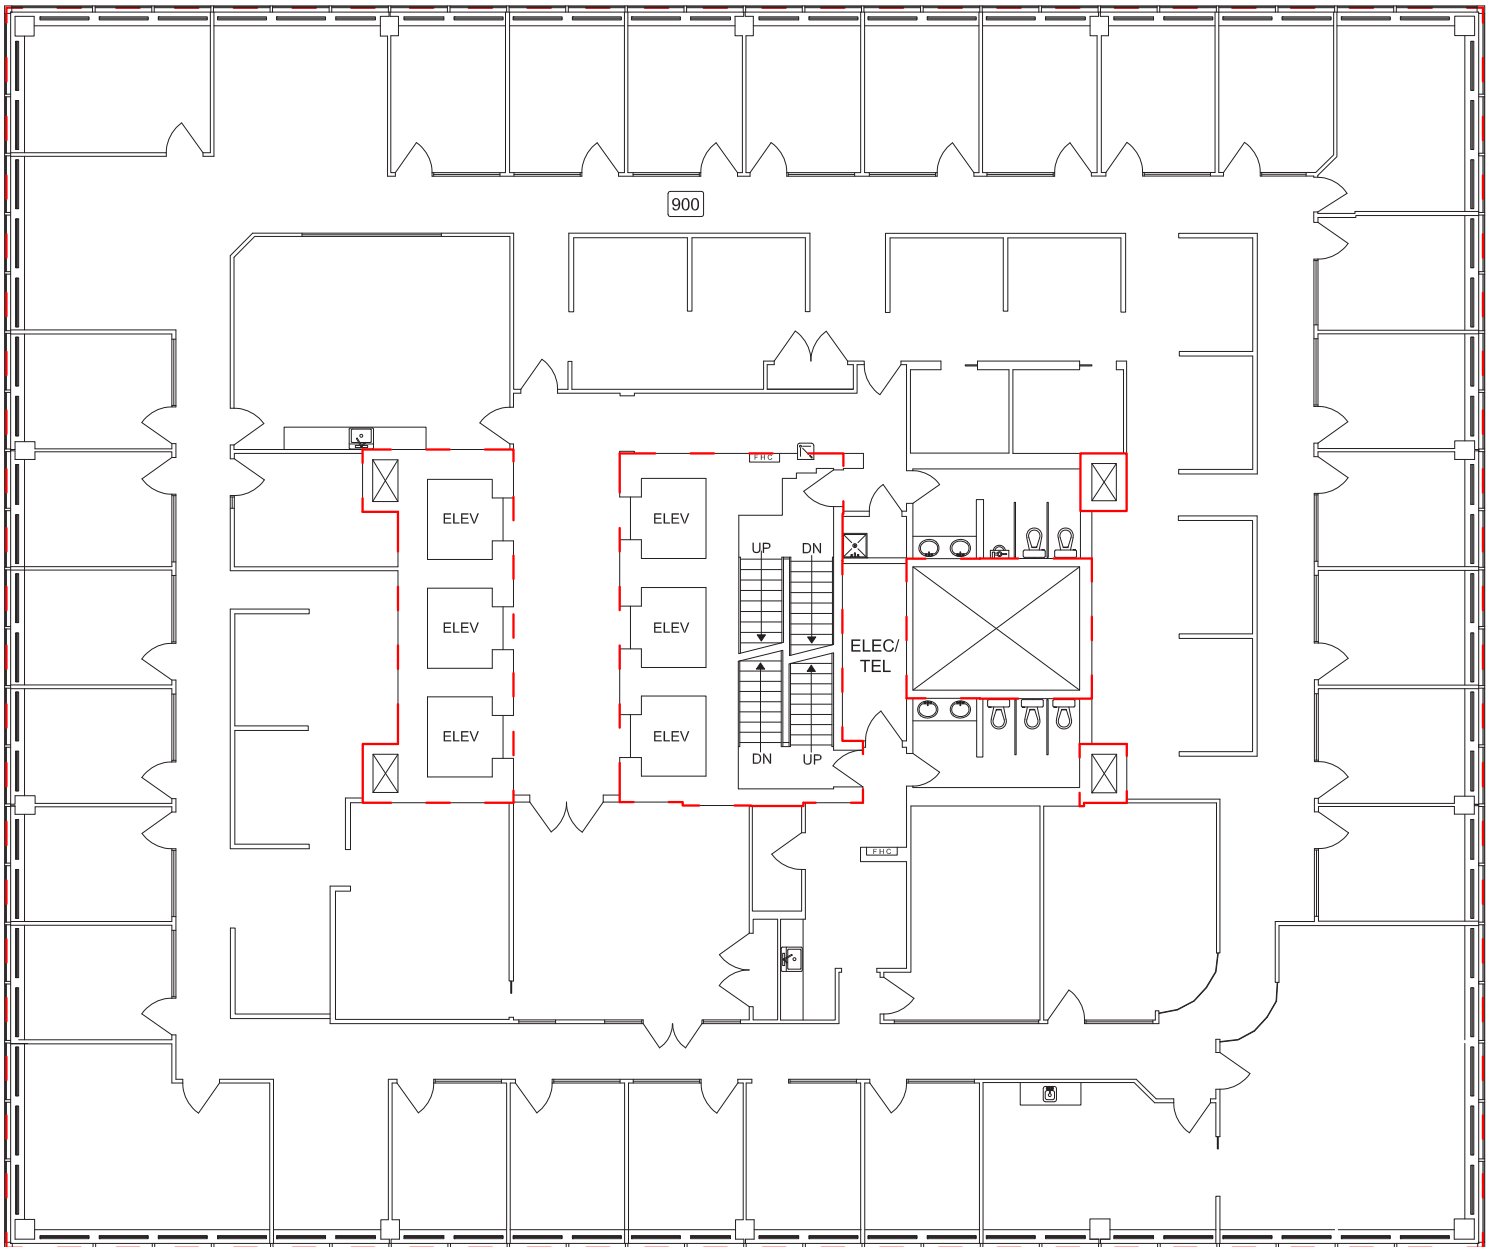


102A Tower

FLOORPLAN
SUITE 1200 - 10,345 SF



CITY CENTRE
TOWERS

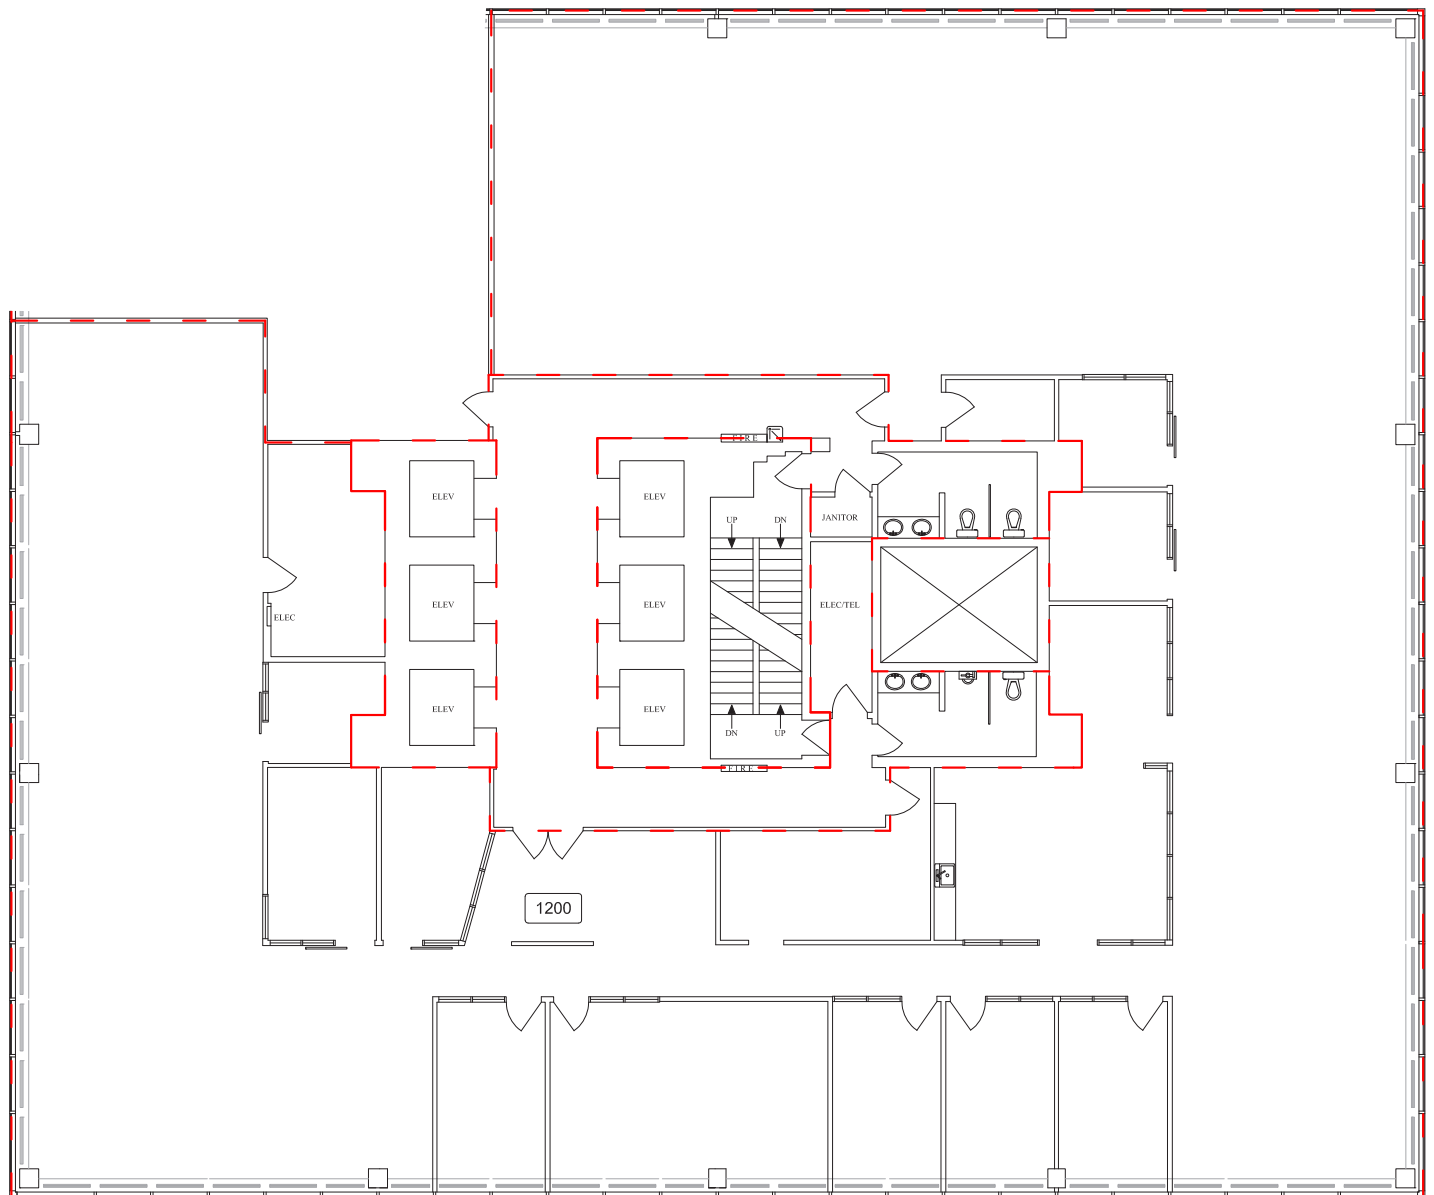


102A Tower

FLOORPLAN
SUITE 1500 - 4,949 SF



CITY CENTRE
TOWERS

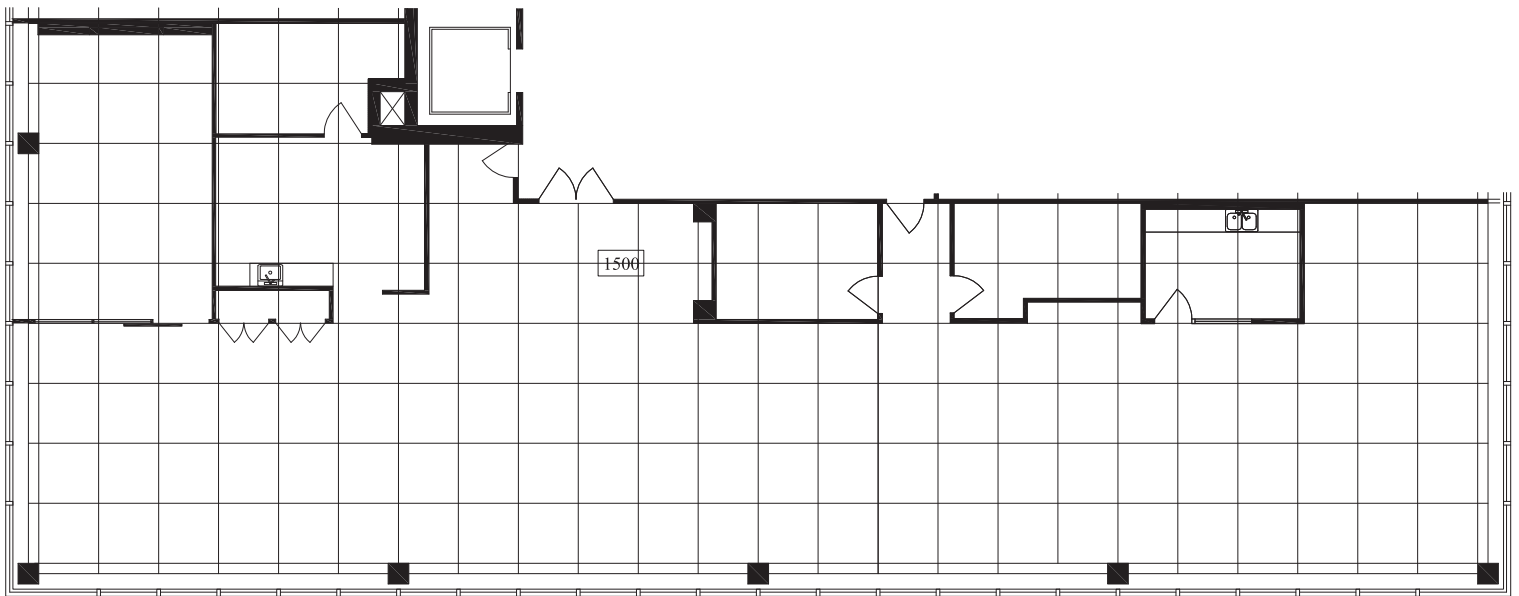


102A Tower

FLOORPLAN
SUITE 1600 - 7,552 SF



CITY CENTRE
TOWERS

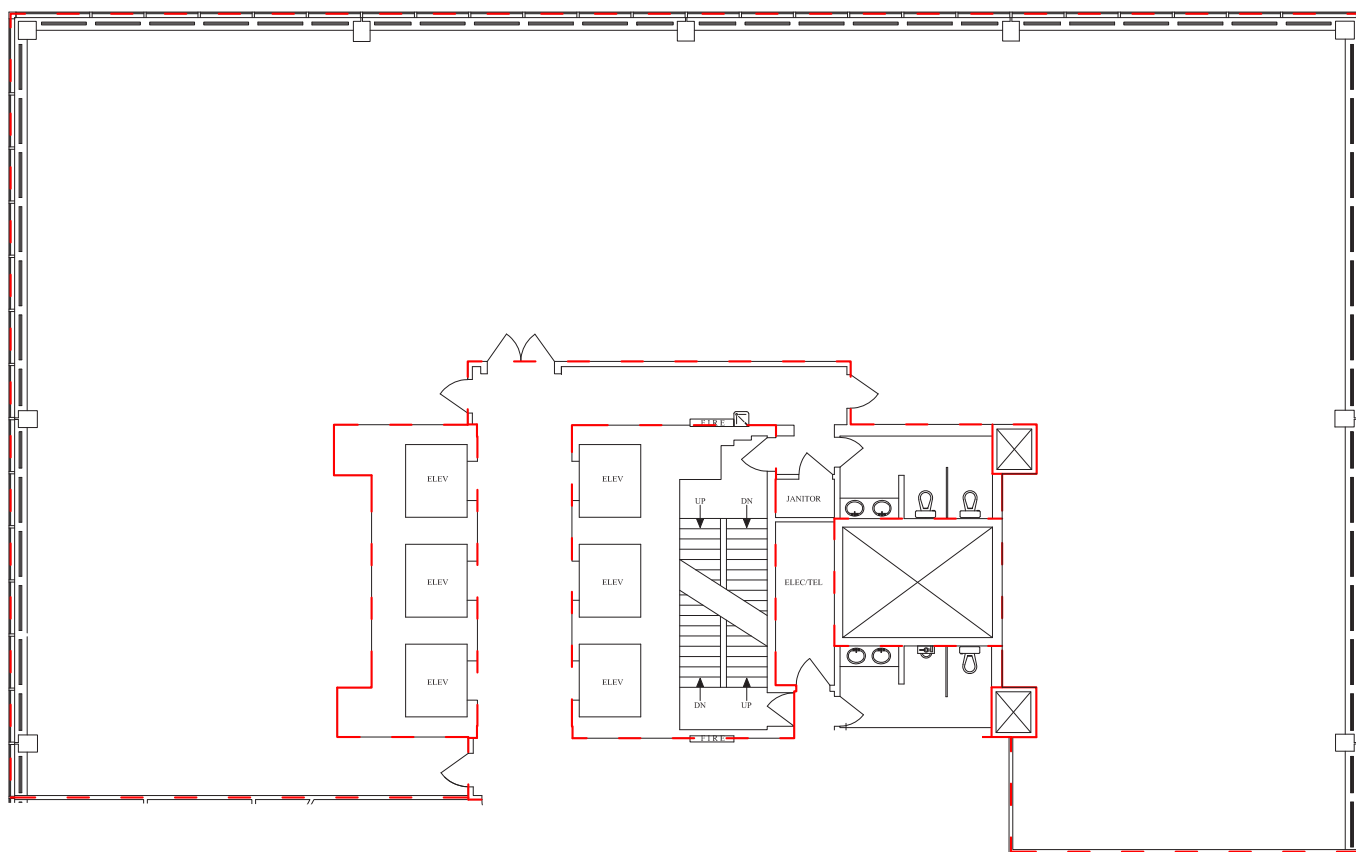

[View Suite Photos](#)


102A Tower

FLOORPLAN

SUITE 1606 - 1,290 SF



CITY CENTRE
TOWERS

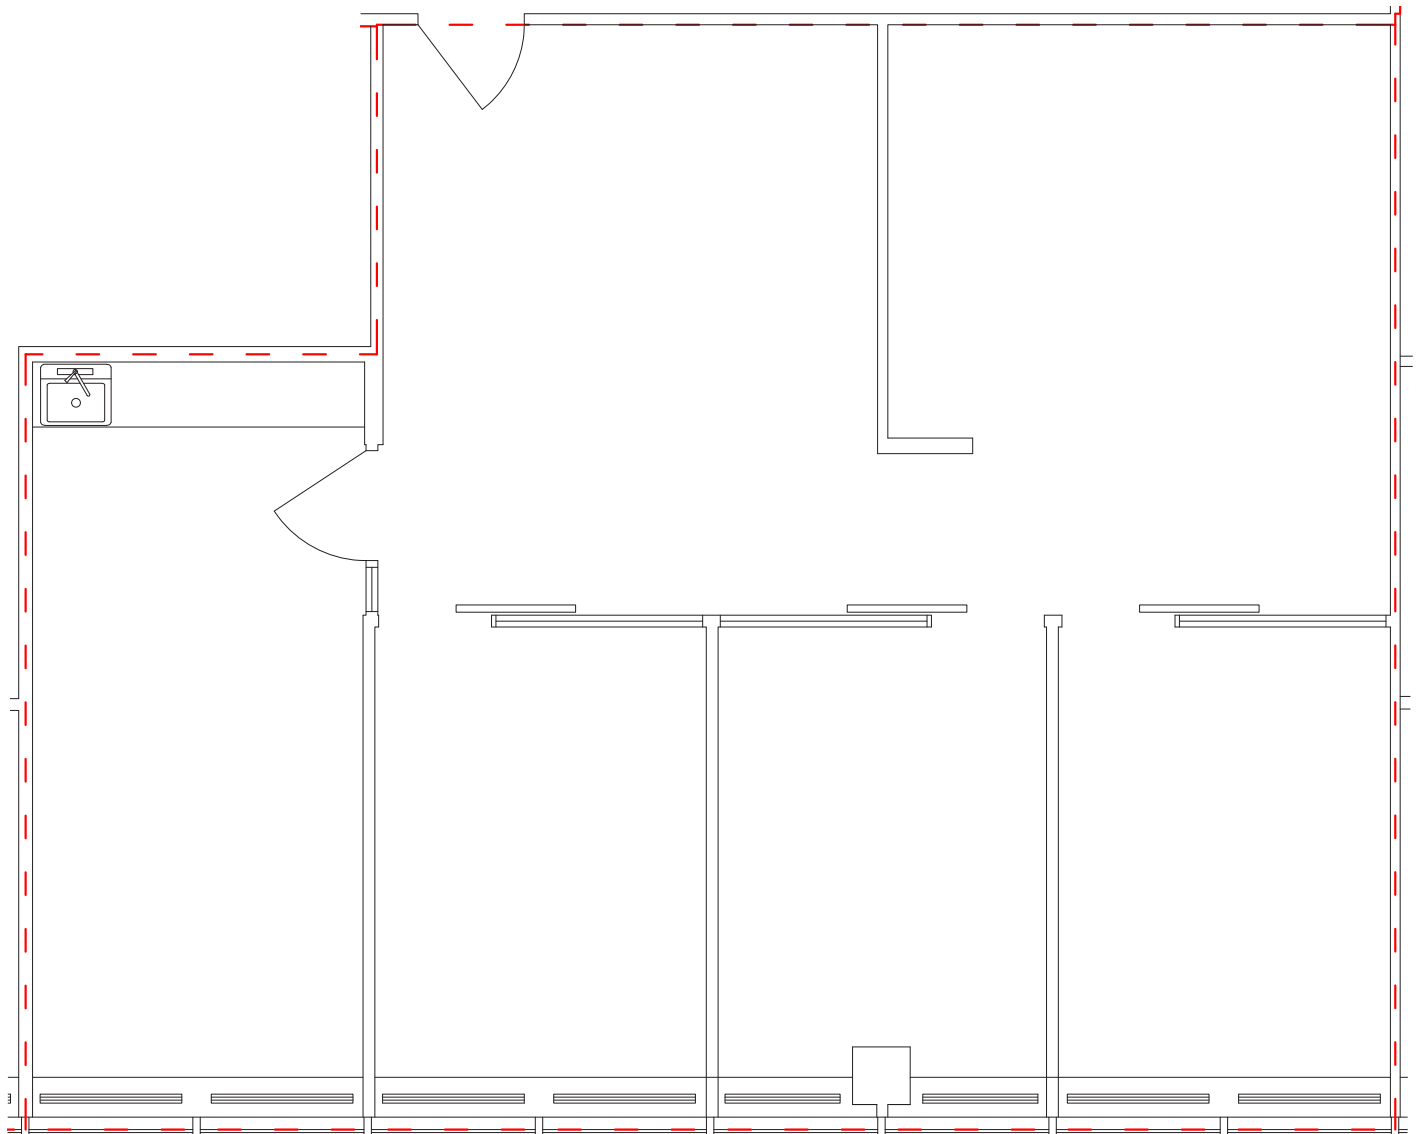


[View Suite Photos](#)

102A Tower

FLOORPLAN
SUITE 1608 - 1,576 SF



CITY CENTRE
TOWERS

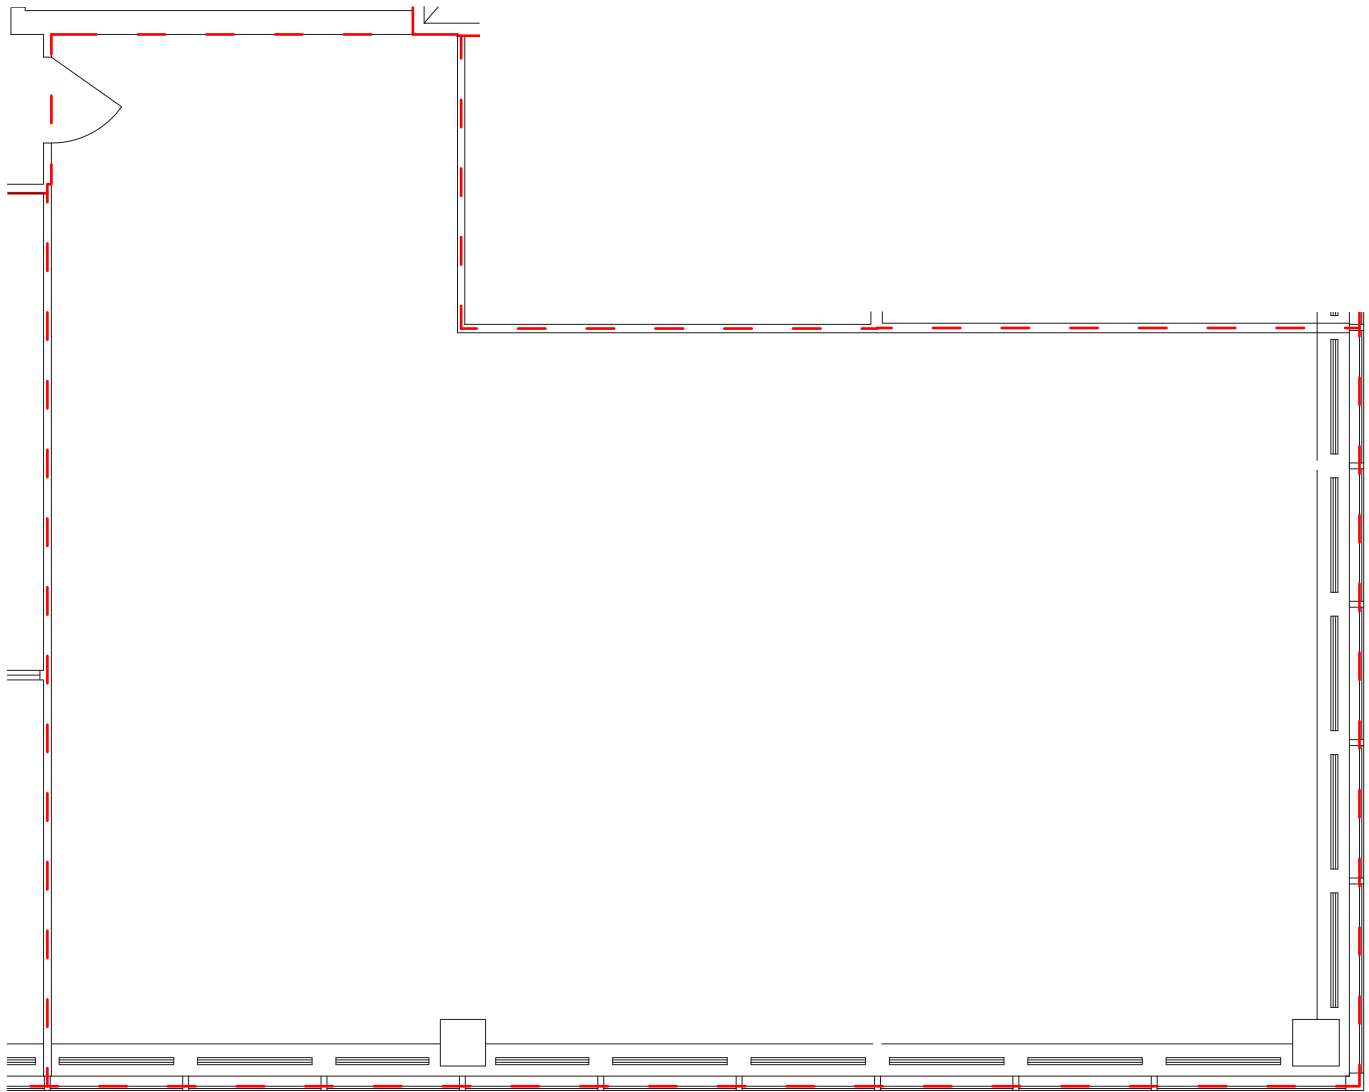


102A Tower

FLOORPLAN
SUITE 1702 - 932 SF



CITY CENTRE
TOWERS

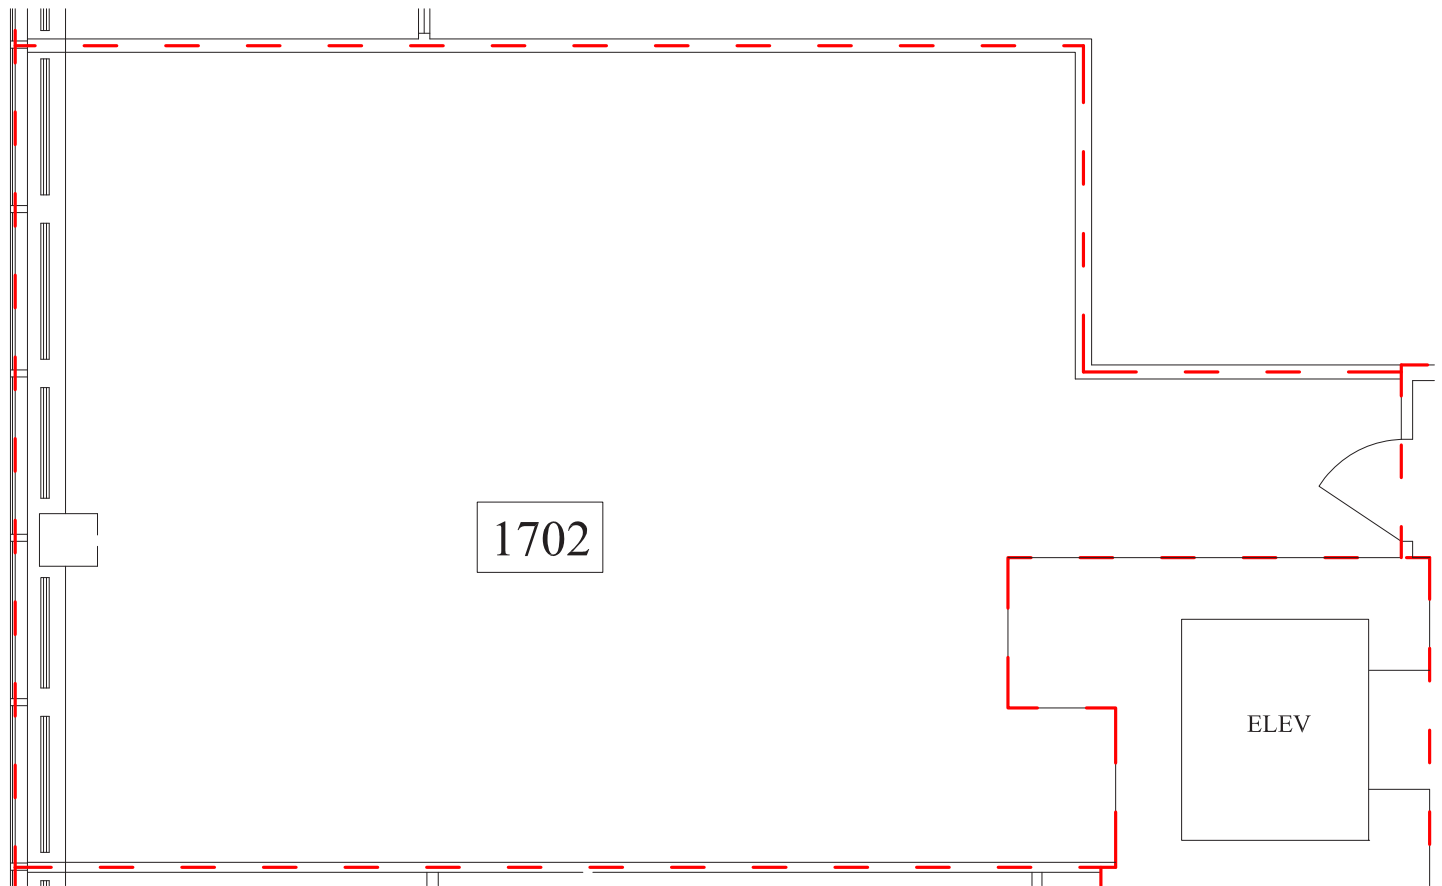


102A Tower

FLOORPLAN
SUITE 1800 - 3,247 SF



CITY CENTRE
TOWERS

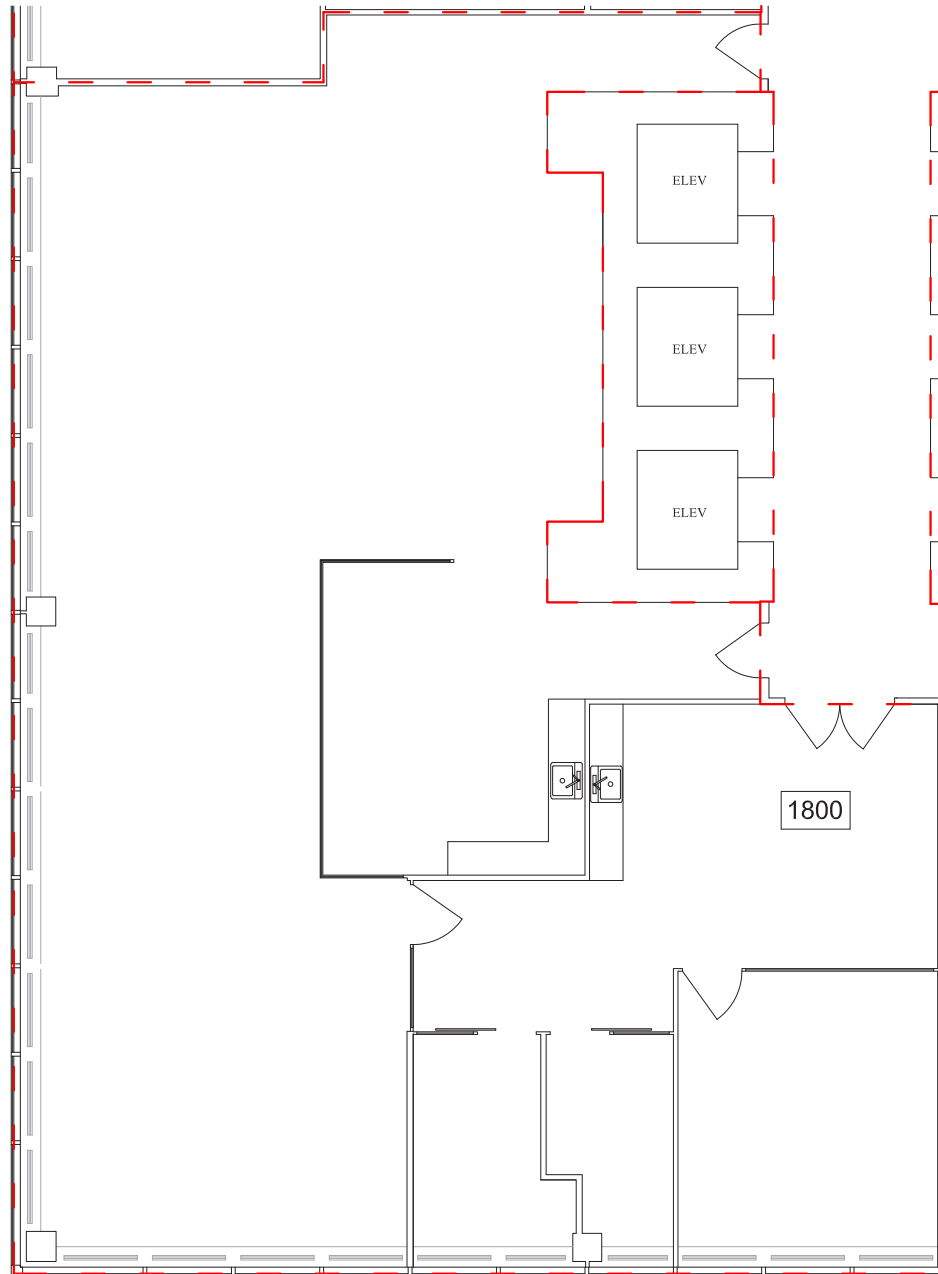


[View Suite Photos](#)

102A Tower

FLOORPLAN
SUITE 1812 - 1,969 SF



CITY CENTRE
TOWERS

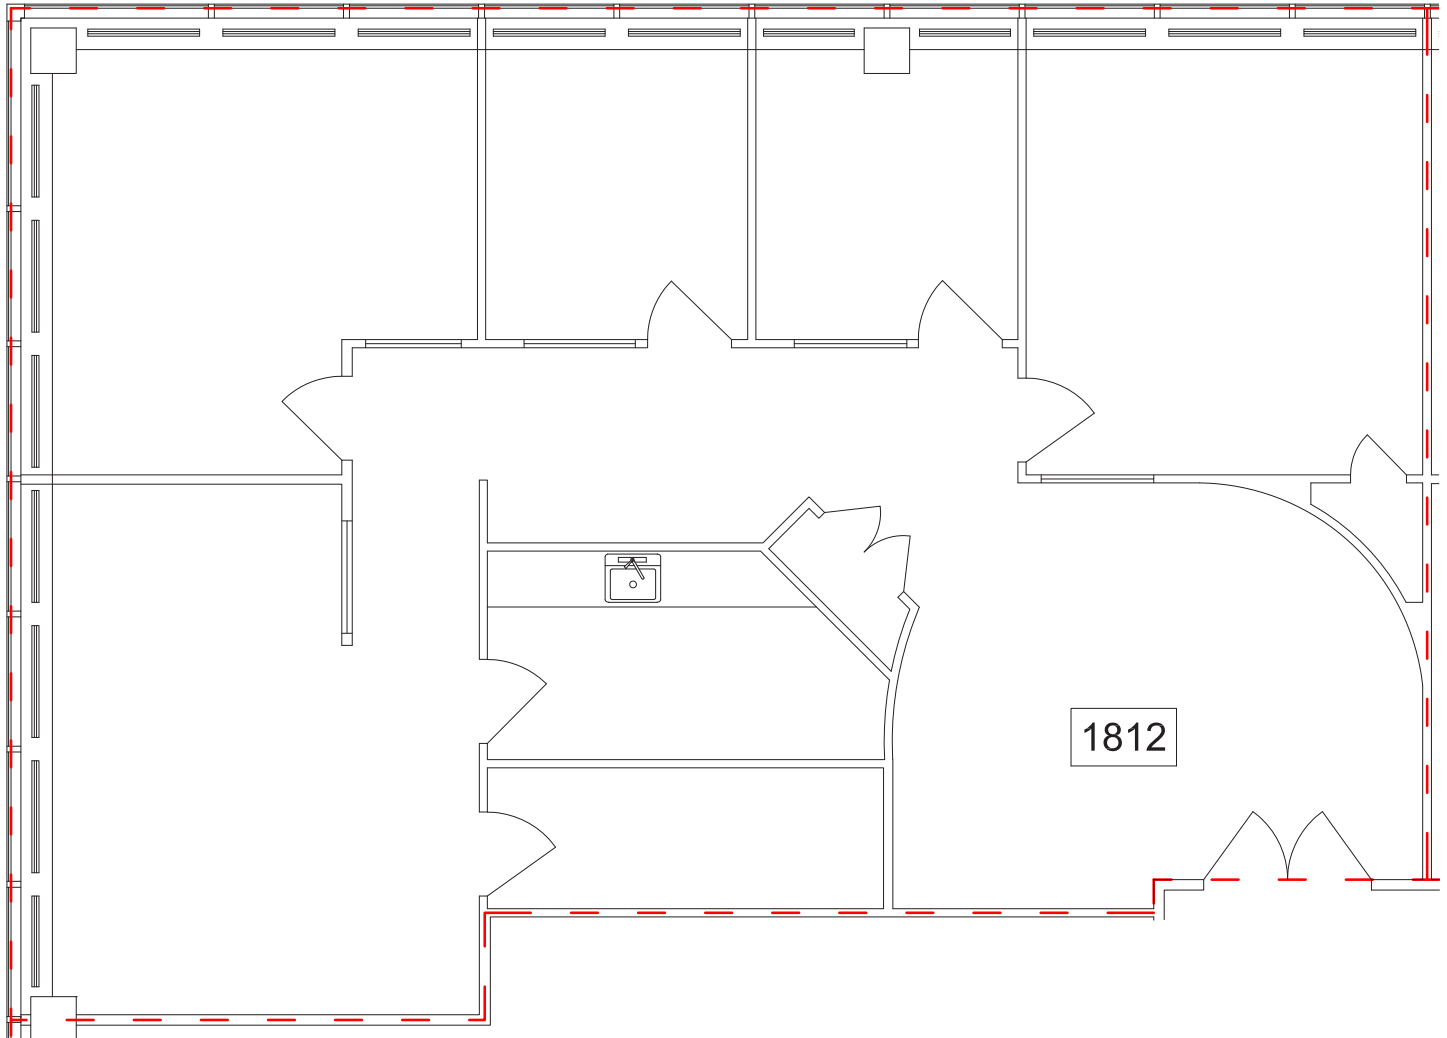

1812


[View Suite Photos](#)

102A Tower

FLOORPLAN
20TH FLOOR - 11,839 SF



CITY CENTRE
TOWERS

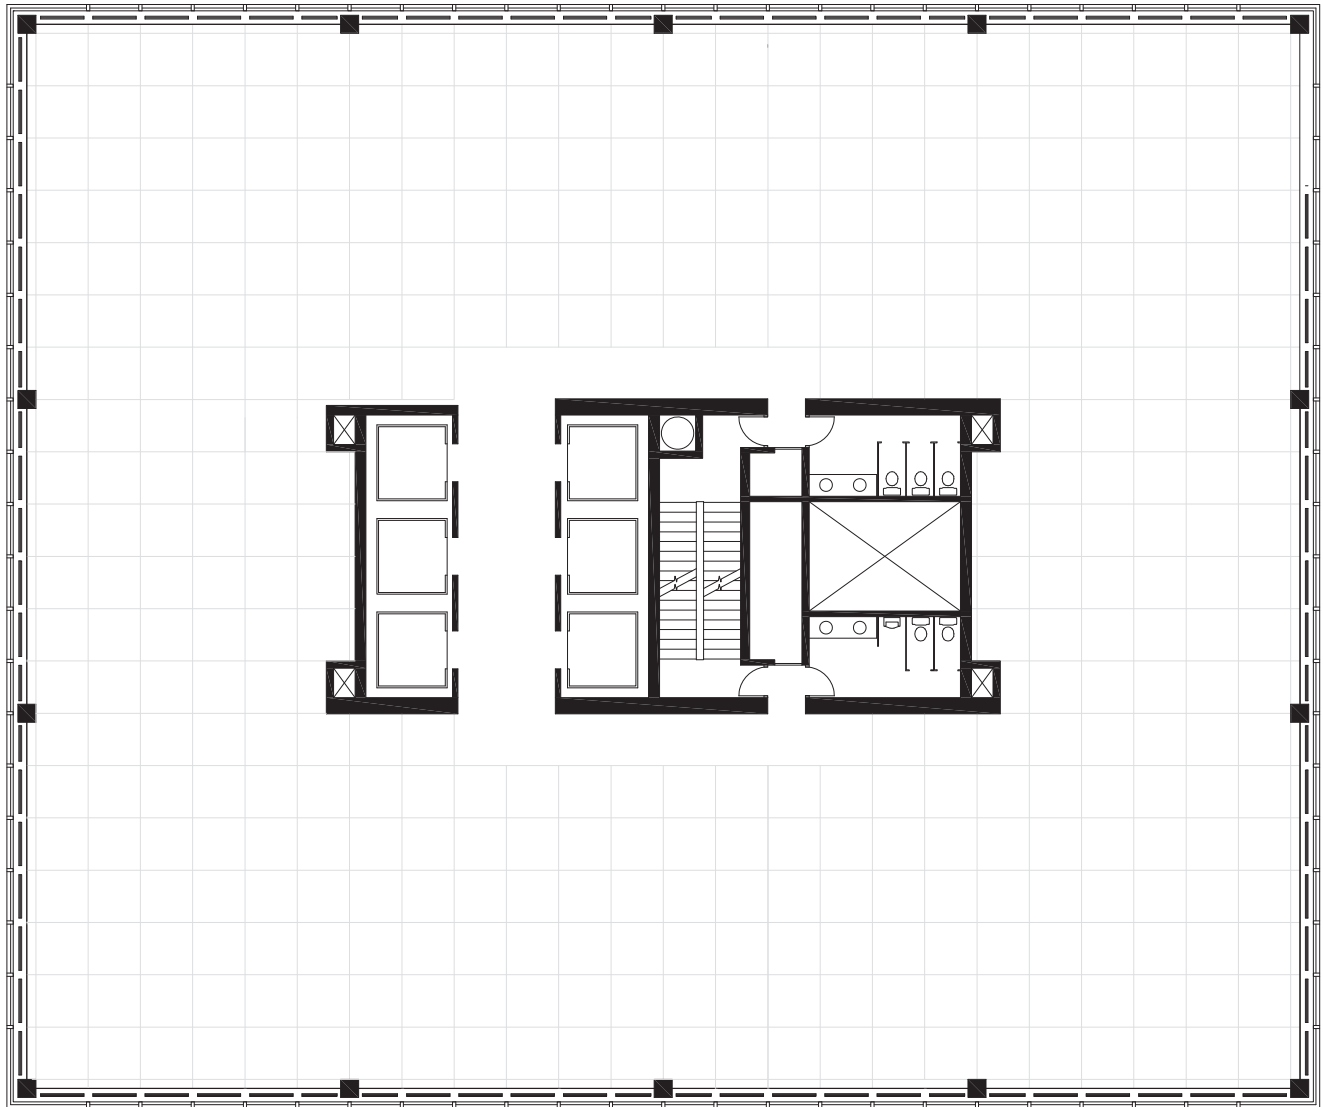


[View Floor Photos](#)

102A Tower

FLOORPLAN
21ST FLOOR - 11,834 SF



CITY CENTRE
TOWERS

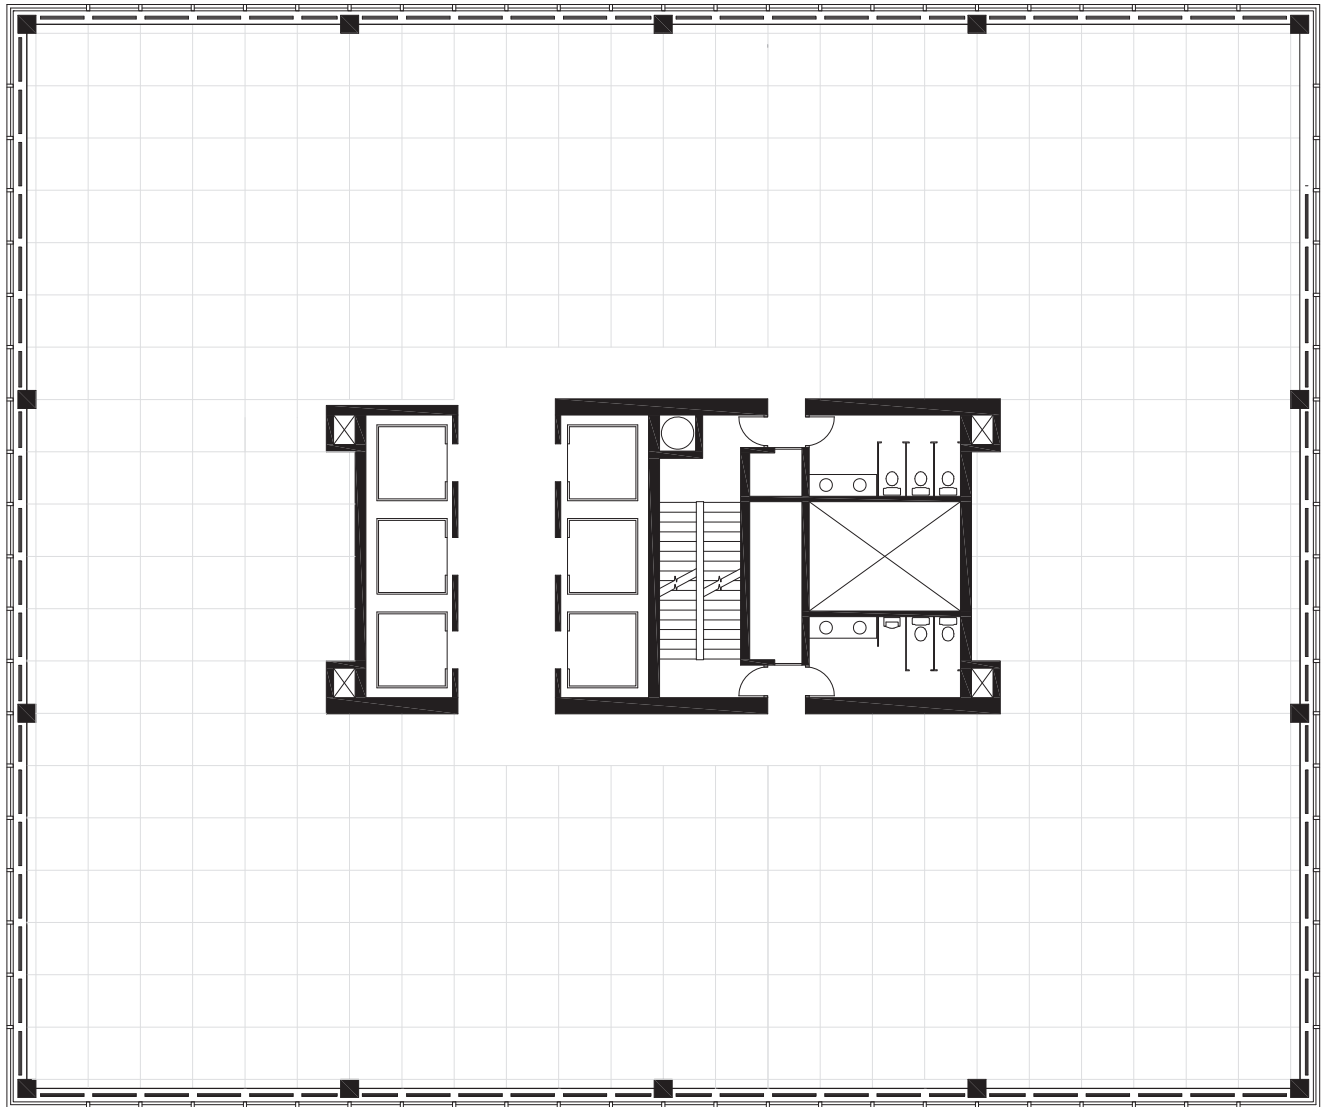

102A TOWER

Conceptual Space Plans




CITY CENTRE
TOWERS

102A Tower

CONCEPTUAL PLAN
SUITE 1608 - 1,576 SF



CITY CENTRE
TOWERS

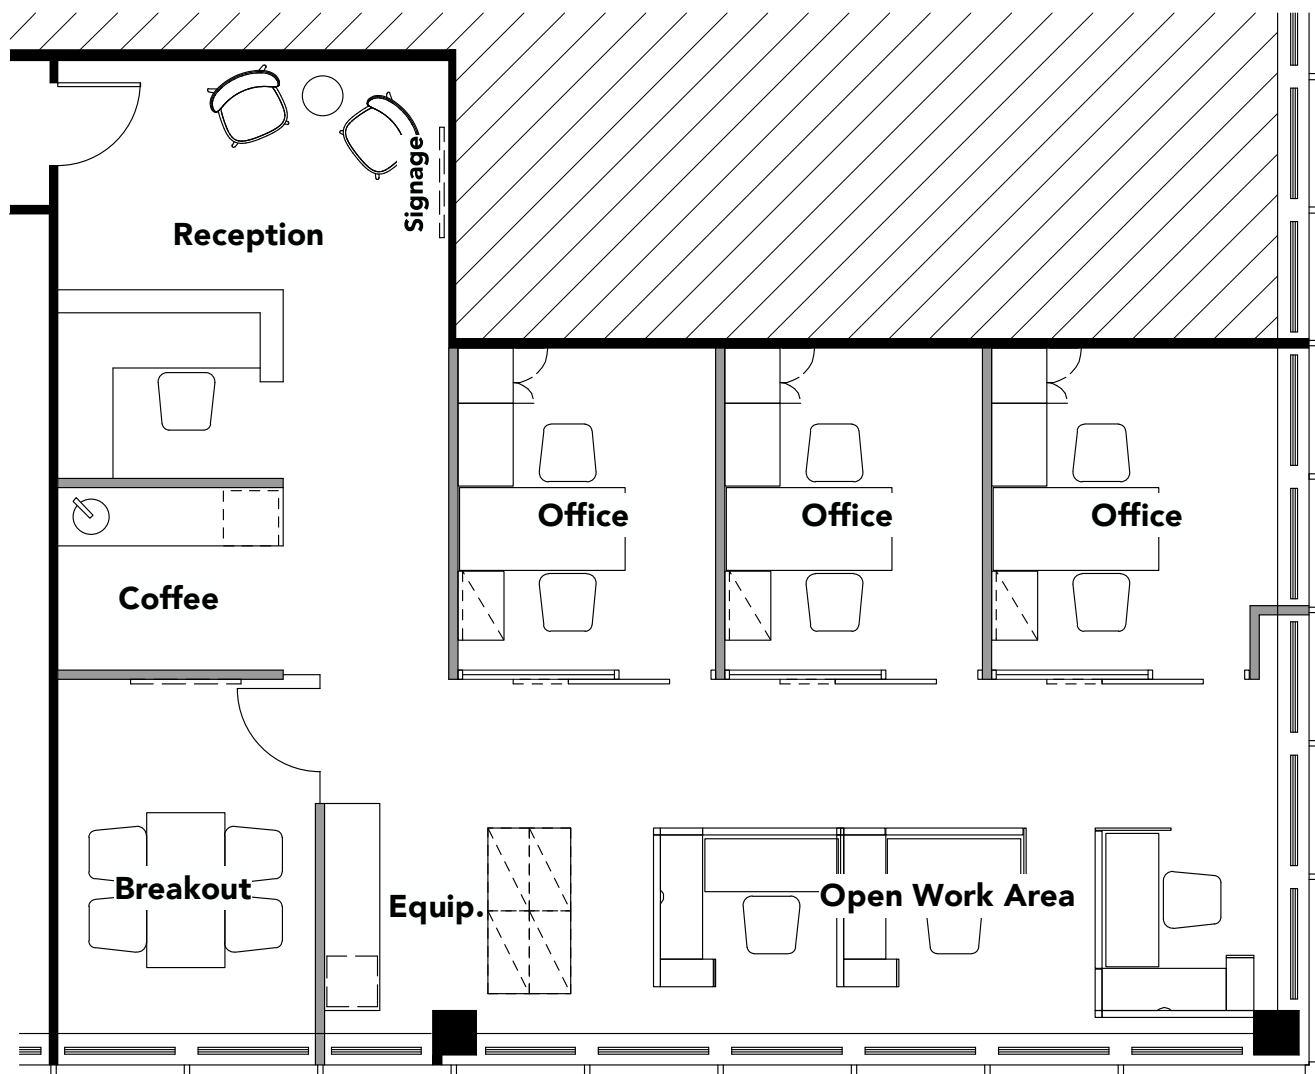


102A Tower

CONCEPTUAL PLAN
FULL FLOOR - OFFICE INTENSIVE



CITY CENTRE
TOWERS

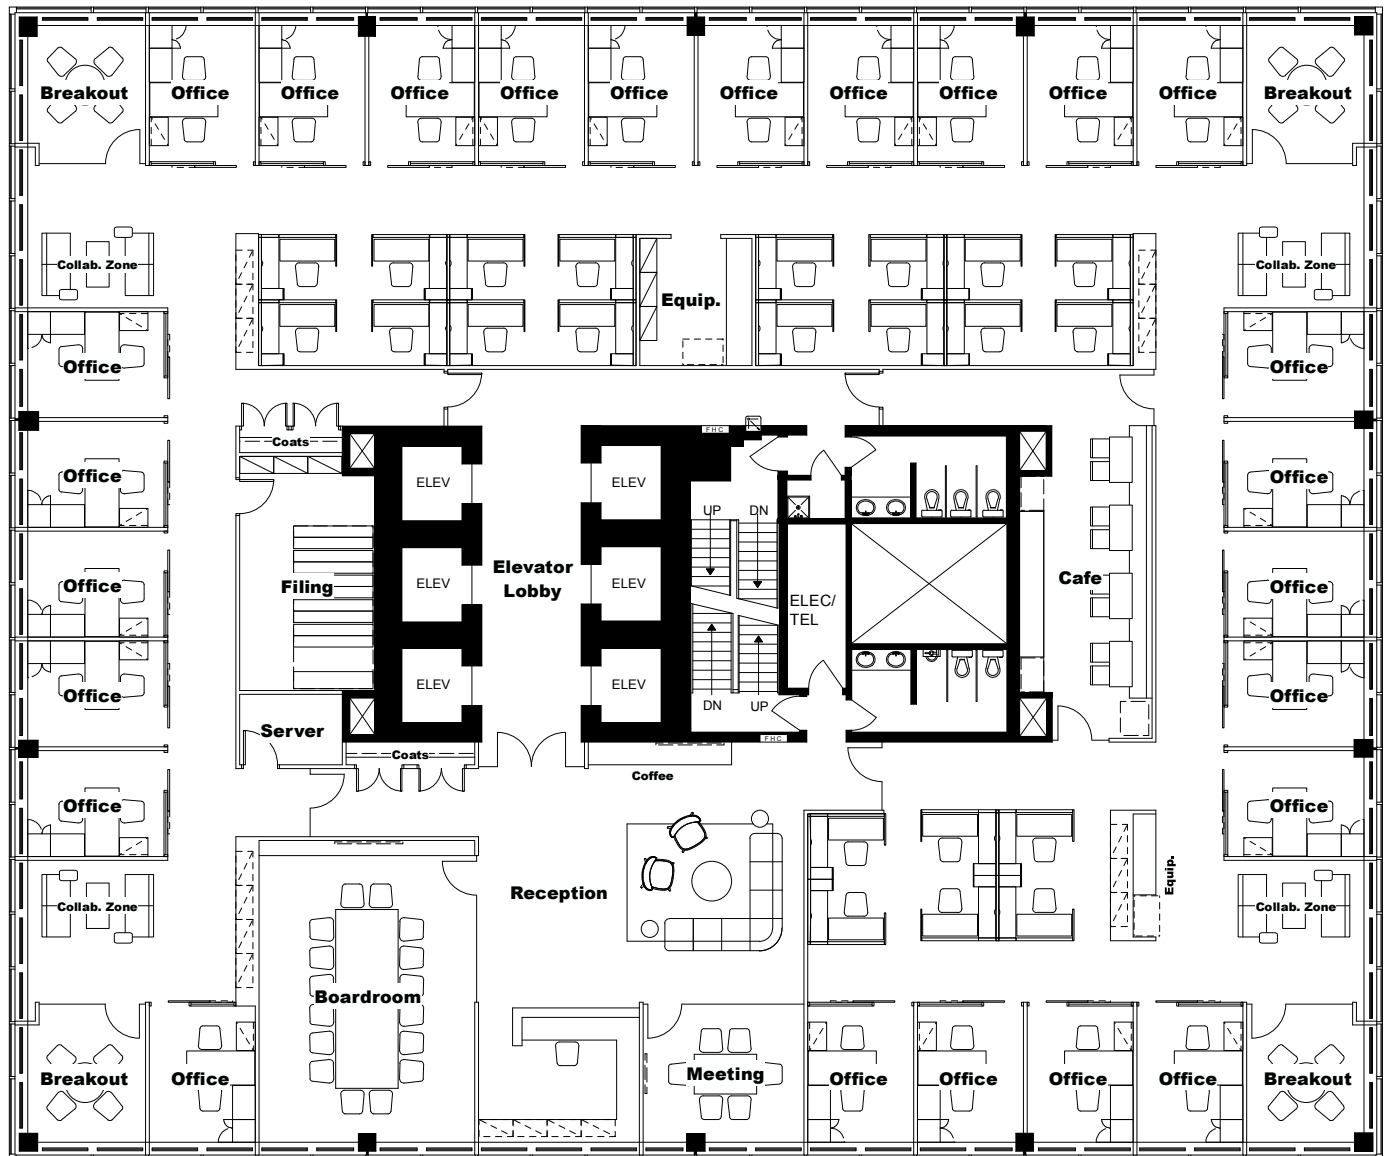


102A Tower

CONCEPTUAL PLAN
FULL FLOOR - WORKSTATION BASED



CITY CENTRE
TOWERS

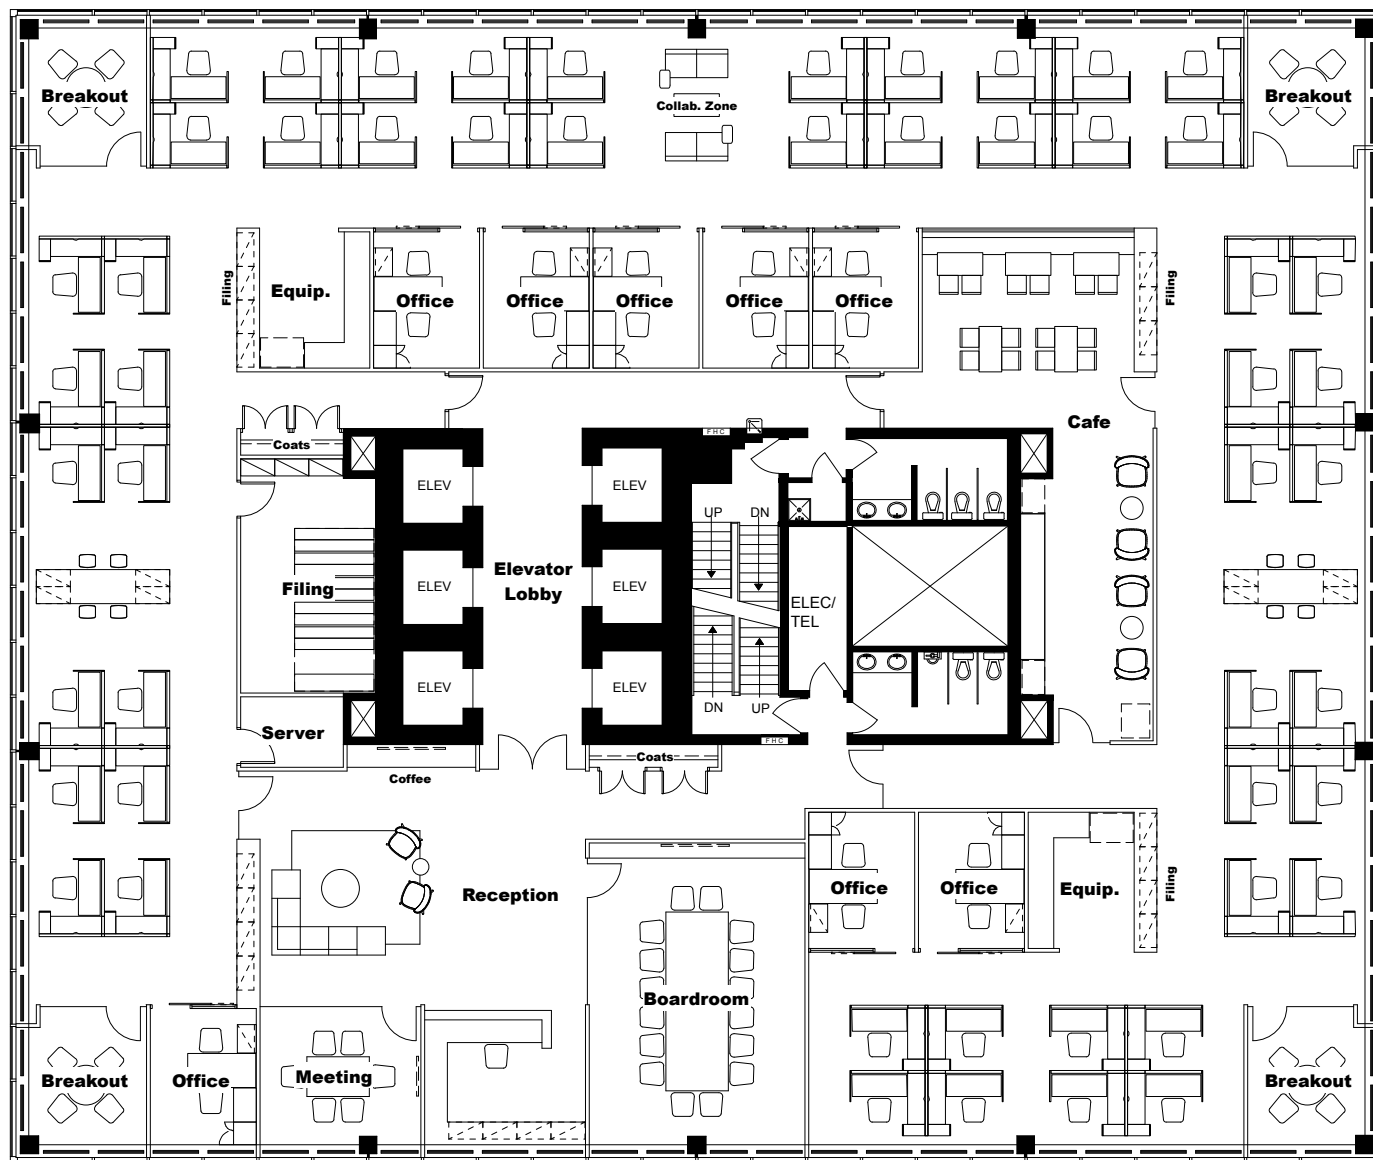

102A Tower

CONCEPTUAL PLAN
FULL FLOOR - HYBRID WORK



CITY CENTRE
TOWERS

