


MAIN LEVEL
 4,050 SQ. FT.
 VARIOUS CEILING
 HEIGHTS NOTED
 ON PLAN

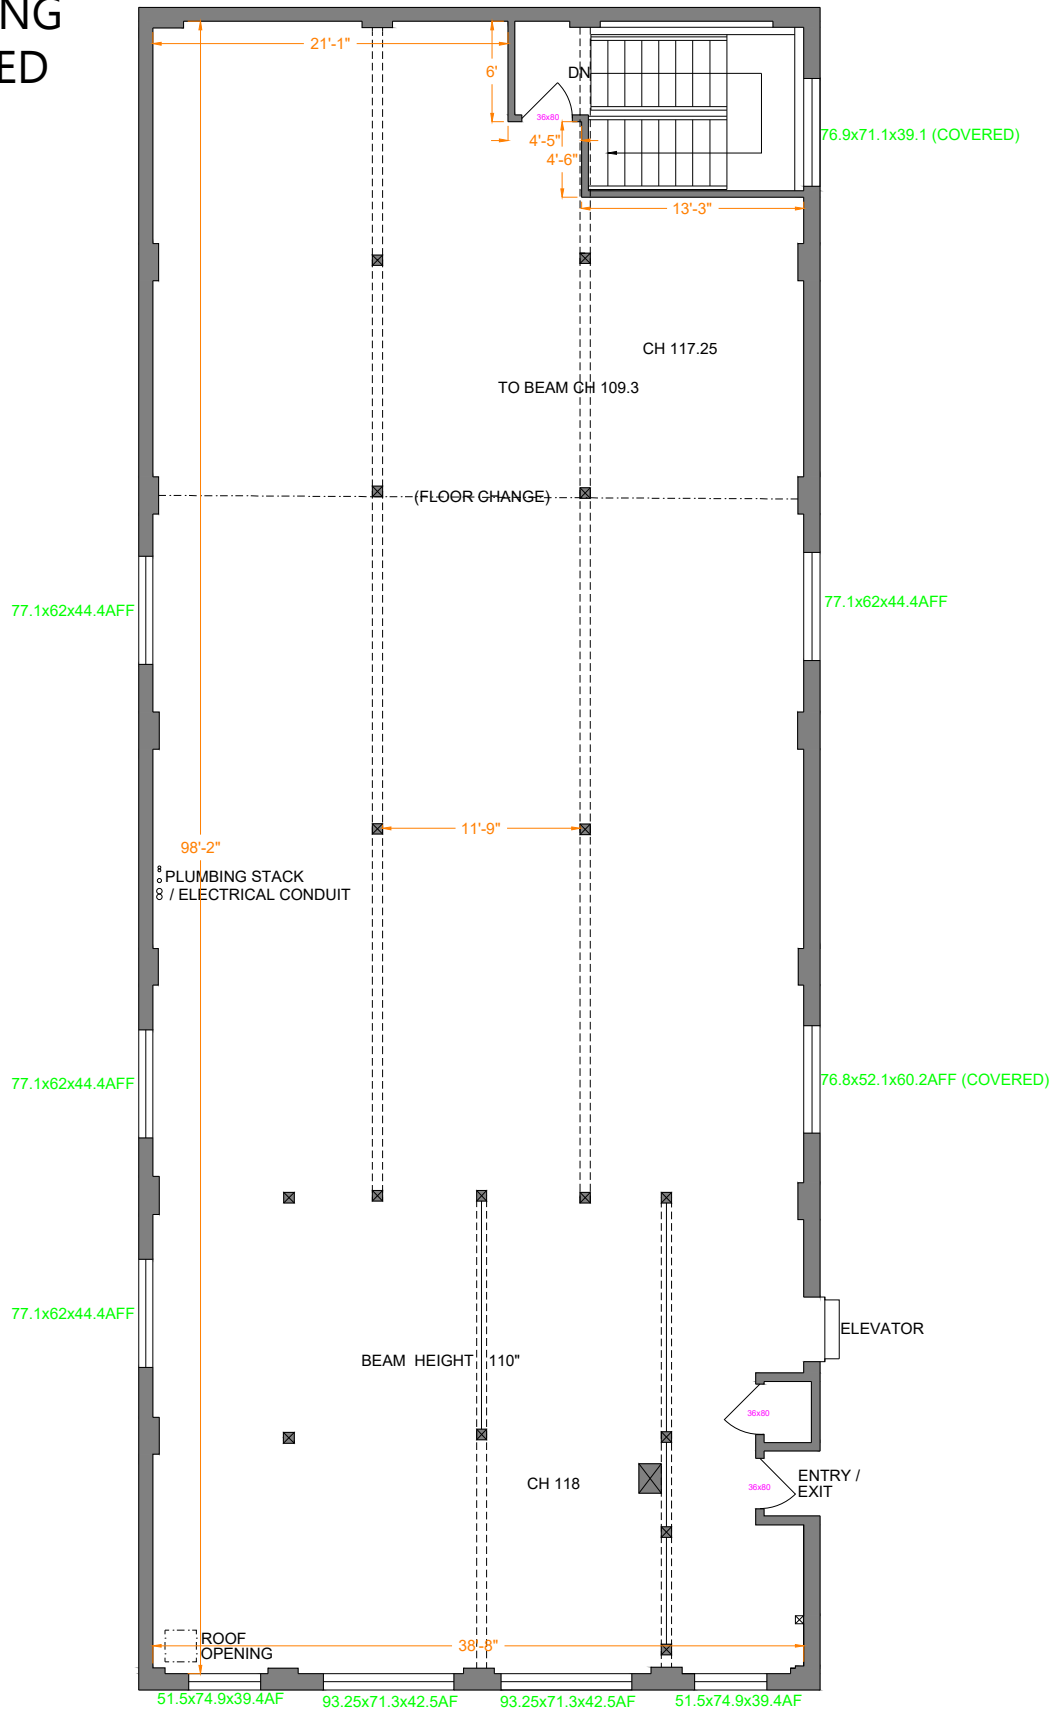

3RD LEVEL - 1264 ELLIS STREET, KELOWNA, B.C. - V1Y 1Z4 MARCH 23, 2026 PREPARED FOR THE EXCLUSIVE USE OF - WHITWORTH HOLDINGS LTD. PLANS MAY NOT BE 100% ACCURATE, IF CRITICAL VERIFY ON SITE <small>COPYRIGHT OF PROPER MEASURE OKANAGAN VALLEY LTD. RESALE OR MODIFICATIONS WITHOUT AUTHORIZED CONSENT IS PROHIBITED.</small> Drawing Type: As Built Floor Plan - Plan Rev: 0 - DWS Scale 1:40	0' 5' 10' SCALE	NORTH 	LEVEL	AREA (SQ. FT.)
				FINISHED
			3RD LEVEL	4,050
TOTAL	4,050			