



MAIN LEVEL
4,524 SQ. FT.
9' CEILING HEIGHT
UNLESS NOTED

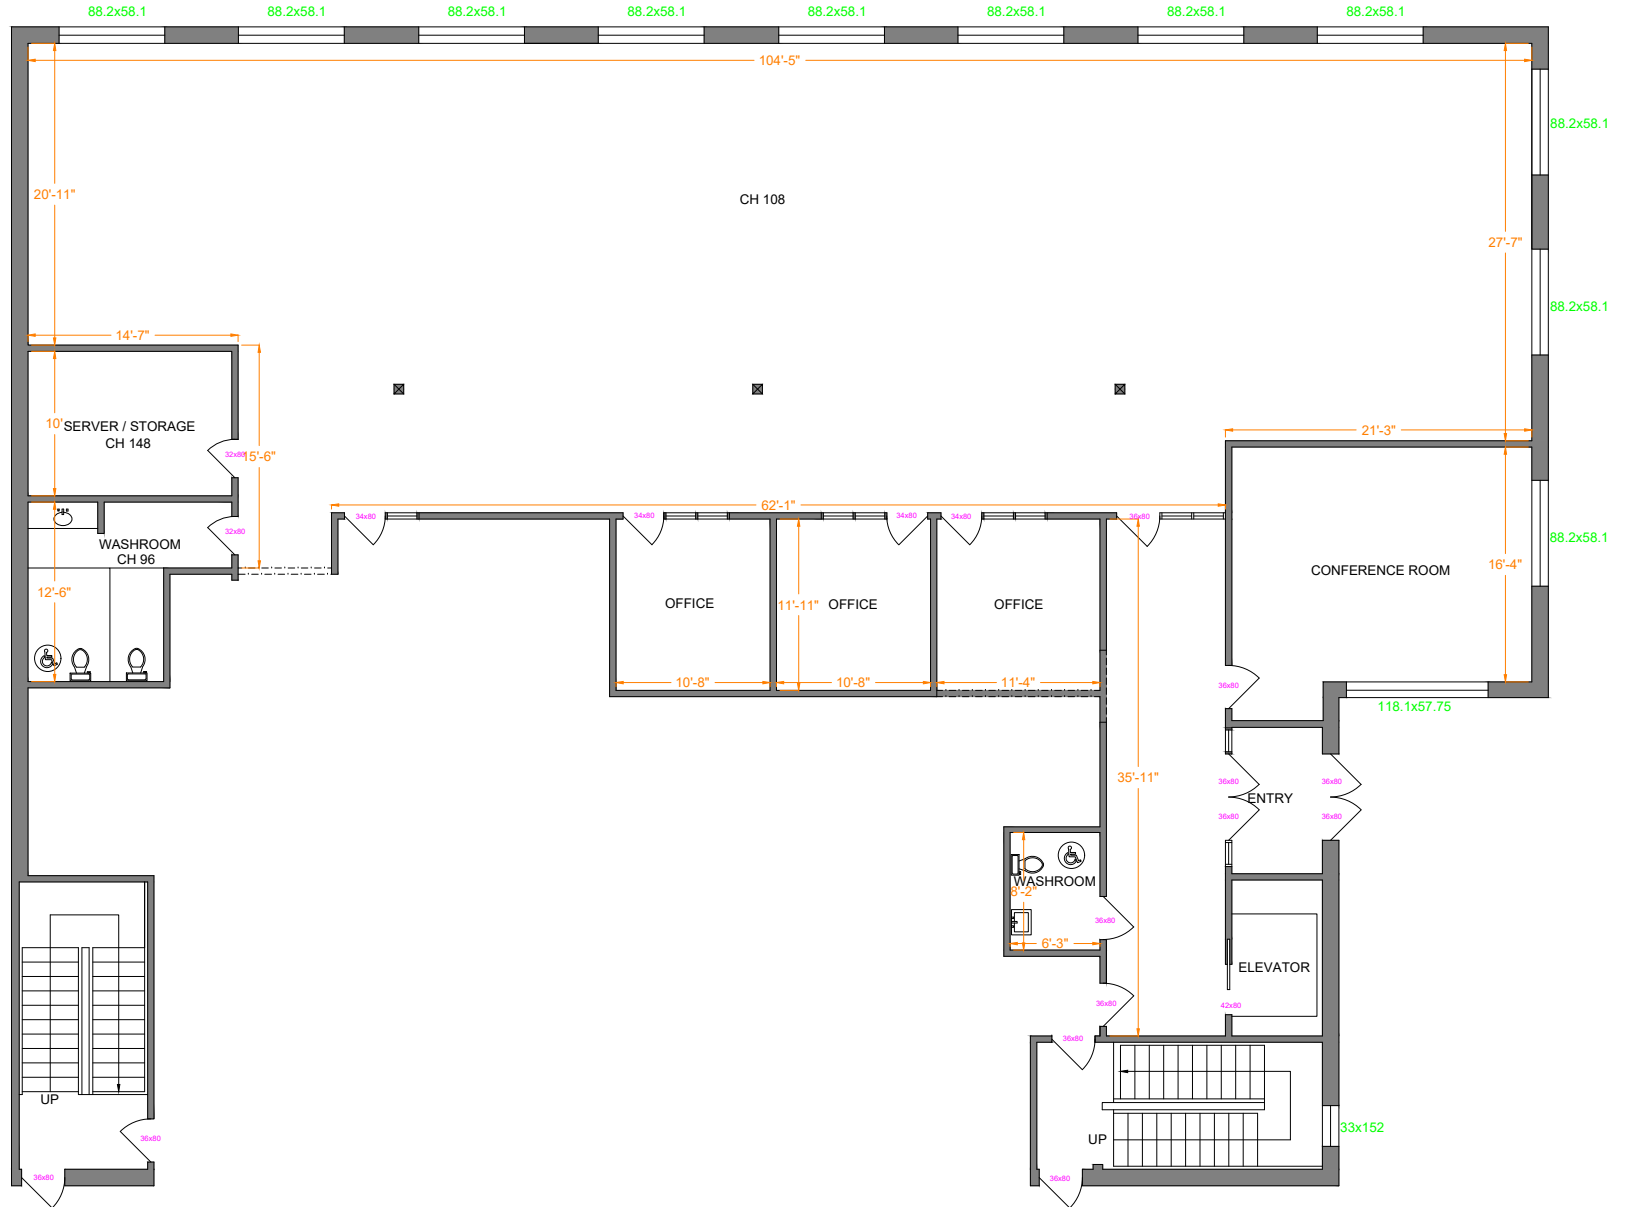

1090 MANHATTAN DRIVE, KELOWNA, B.C. V1Y 9X9
JANUARY 16, 2026
PREPARED FOR THE EXCLUSIVE USE OF - WHITWORTH HOLDINGS LTD.
PLANS MAY NOT BE 100% ACCURATE, IF CRITICAL VERIFY ON SITE
COPYRIGHT OF PROPER MEASURE OKANAGAN VALLEY LTD. RESALE OR MODIFICATIONS WITHOUT AUTHORIZED CONSENT IS PROHIBITED.
Drawing Type: As Built Floor Plan - Plan Rev: 1 - DWG Scale 1:40

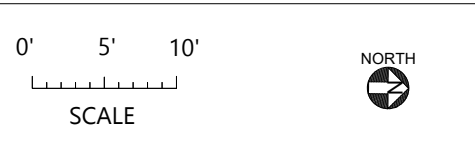

LEVEL	AREA (SQ. FT.)		
	FINISHED	COMMON LOBBY	COMMON AREA STAIRS
MAIN	4,524	561	428
UPPER	7,795		
TOTAL	12,048	561	428