


Copyright Reserved
 This plan and design are, and at all times remain the exclusive property of the architect/designer and cannot be used or reproduced without written consent. Written dimensions shall have precedence over scaled dimensions. Contractors shall verify and be responsible for all dimensions and conditions on the job and this office shall be informed of any variations from the dimensions and conditions shown on the drawing.

REVISIONS			
No.	Date	Description	By
1	MAY-27-2016	ISSUED FOR DNV REVIEW	HR
2	JUNE-13-2016	ISSUED FOR DP	SK
3	AUG-31-2016	ADVISORY DESIGN PANEL	SK
4	MAY-16-2017	DP RE-SUBMISSION	HR
5	MAR-02-2018	RE-ISSUED FOR DP	FR
6	JUN-01-2018	BP COORDINATION	HT
7	JUN-27-2018	ISSUED FOR BP	FR
8	AUG-31-2018	RE-ISSUED FOR BP	FR
9	DEC-10-2018	ISSUED FOR TENDER	FR
10	JAN-25-2019	TENDER ADDENDUM #1	FR
22	JAN-16-2021	ISSUED FOR ASH-120	FR
23	JUN-07-2021	ISSUED FOR ASH-176	FR
24	JUN-17-2021	ISSUED FOR ASH-180	FR
25	DEC-07-2021	ISSUED FOR ASH-221	FR
26	FEB-07-2022	ISSUED FOR ASH-232	FR
27	MAR-03-2022	ISSUED FOR ASH-240	FR
28	MAR-09-2022	ISSUED FOR ASH-232 Rev.1	FR
29	SEP-20-2022	RECORD DRAWINGS	FR
30	FEB-21-2023	ISSUED FOR NEW RETAINING WALL	FR
31	MAR-02-2023	ISSUED FOR FOOD STORE REVISIONS	FR
32	MAY-01-2023	FOOD STORE IFC 95%	AG
33	JUNE-08-2023	FOOD STORE IFC	AG
34	SEP-20-2023	FOOD STORE ASH #007	AG
35	JAN-08-2024	FOOD STORE RECORD DRAWINGS	AG

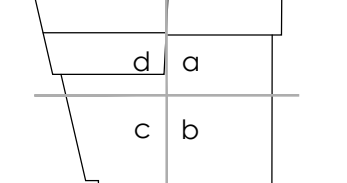

RAFI ARCHITECTS INC.

REGISTERED ARCHITECT
 FOOD SAFE
 BRITISH COLUMBIA

2024-01-10

RAFI

TEL 604.688.3655
 EMAIL rafii@rafiarchitects.com
 WWW rafiiarchitects.com

SUITE ONE
 1600 HOWE ST
 VANCOUVER BC
 V6Z 2L9 CANADA

Members of Architectural Institute of B.C.

Client
KELTIC (CAPILANO) DEVELOPMENT LTD.


Project
PARK WEST
 1633 CAPILANO ROAD
 (AT MARINE DRIVE)

Drawing Title
**FLOOR PLAN
 LEVEL 1 LOWER - OVERALL**

Date: JANUARY 2024
 Project No. 12-16

Scale: 1/16"=1'-0"
 Drawing No. A

Drawn By: AG
 File name: HA.12-16.PRINTSET
2-04

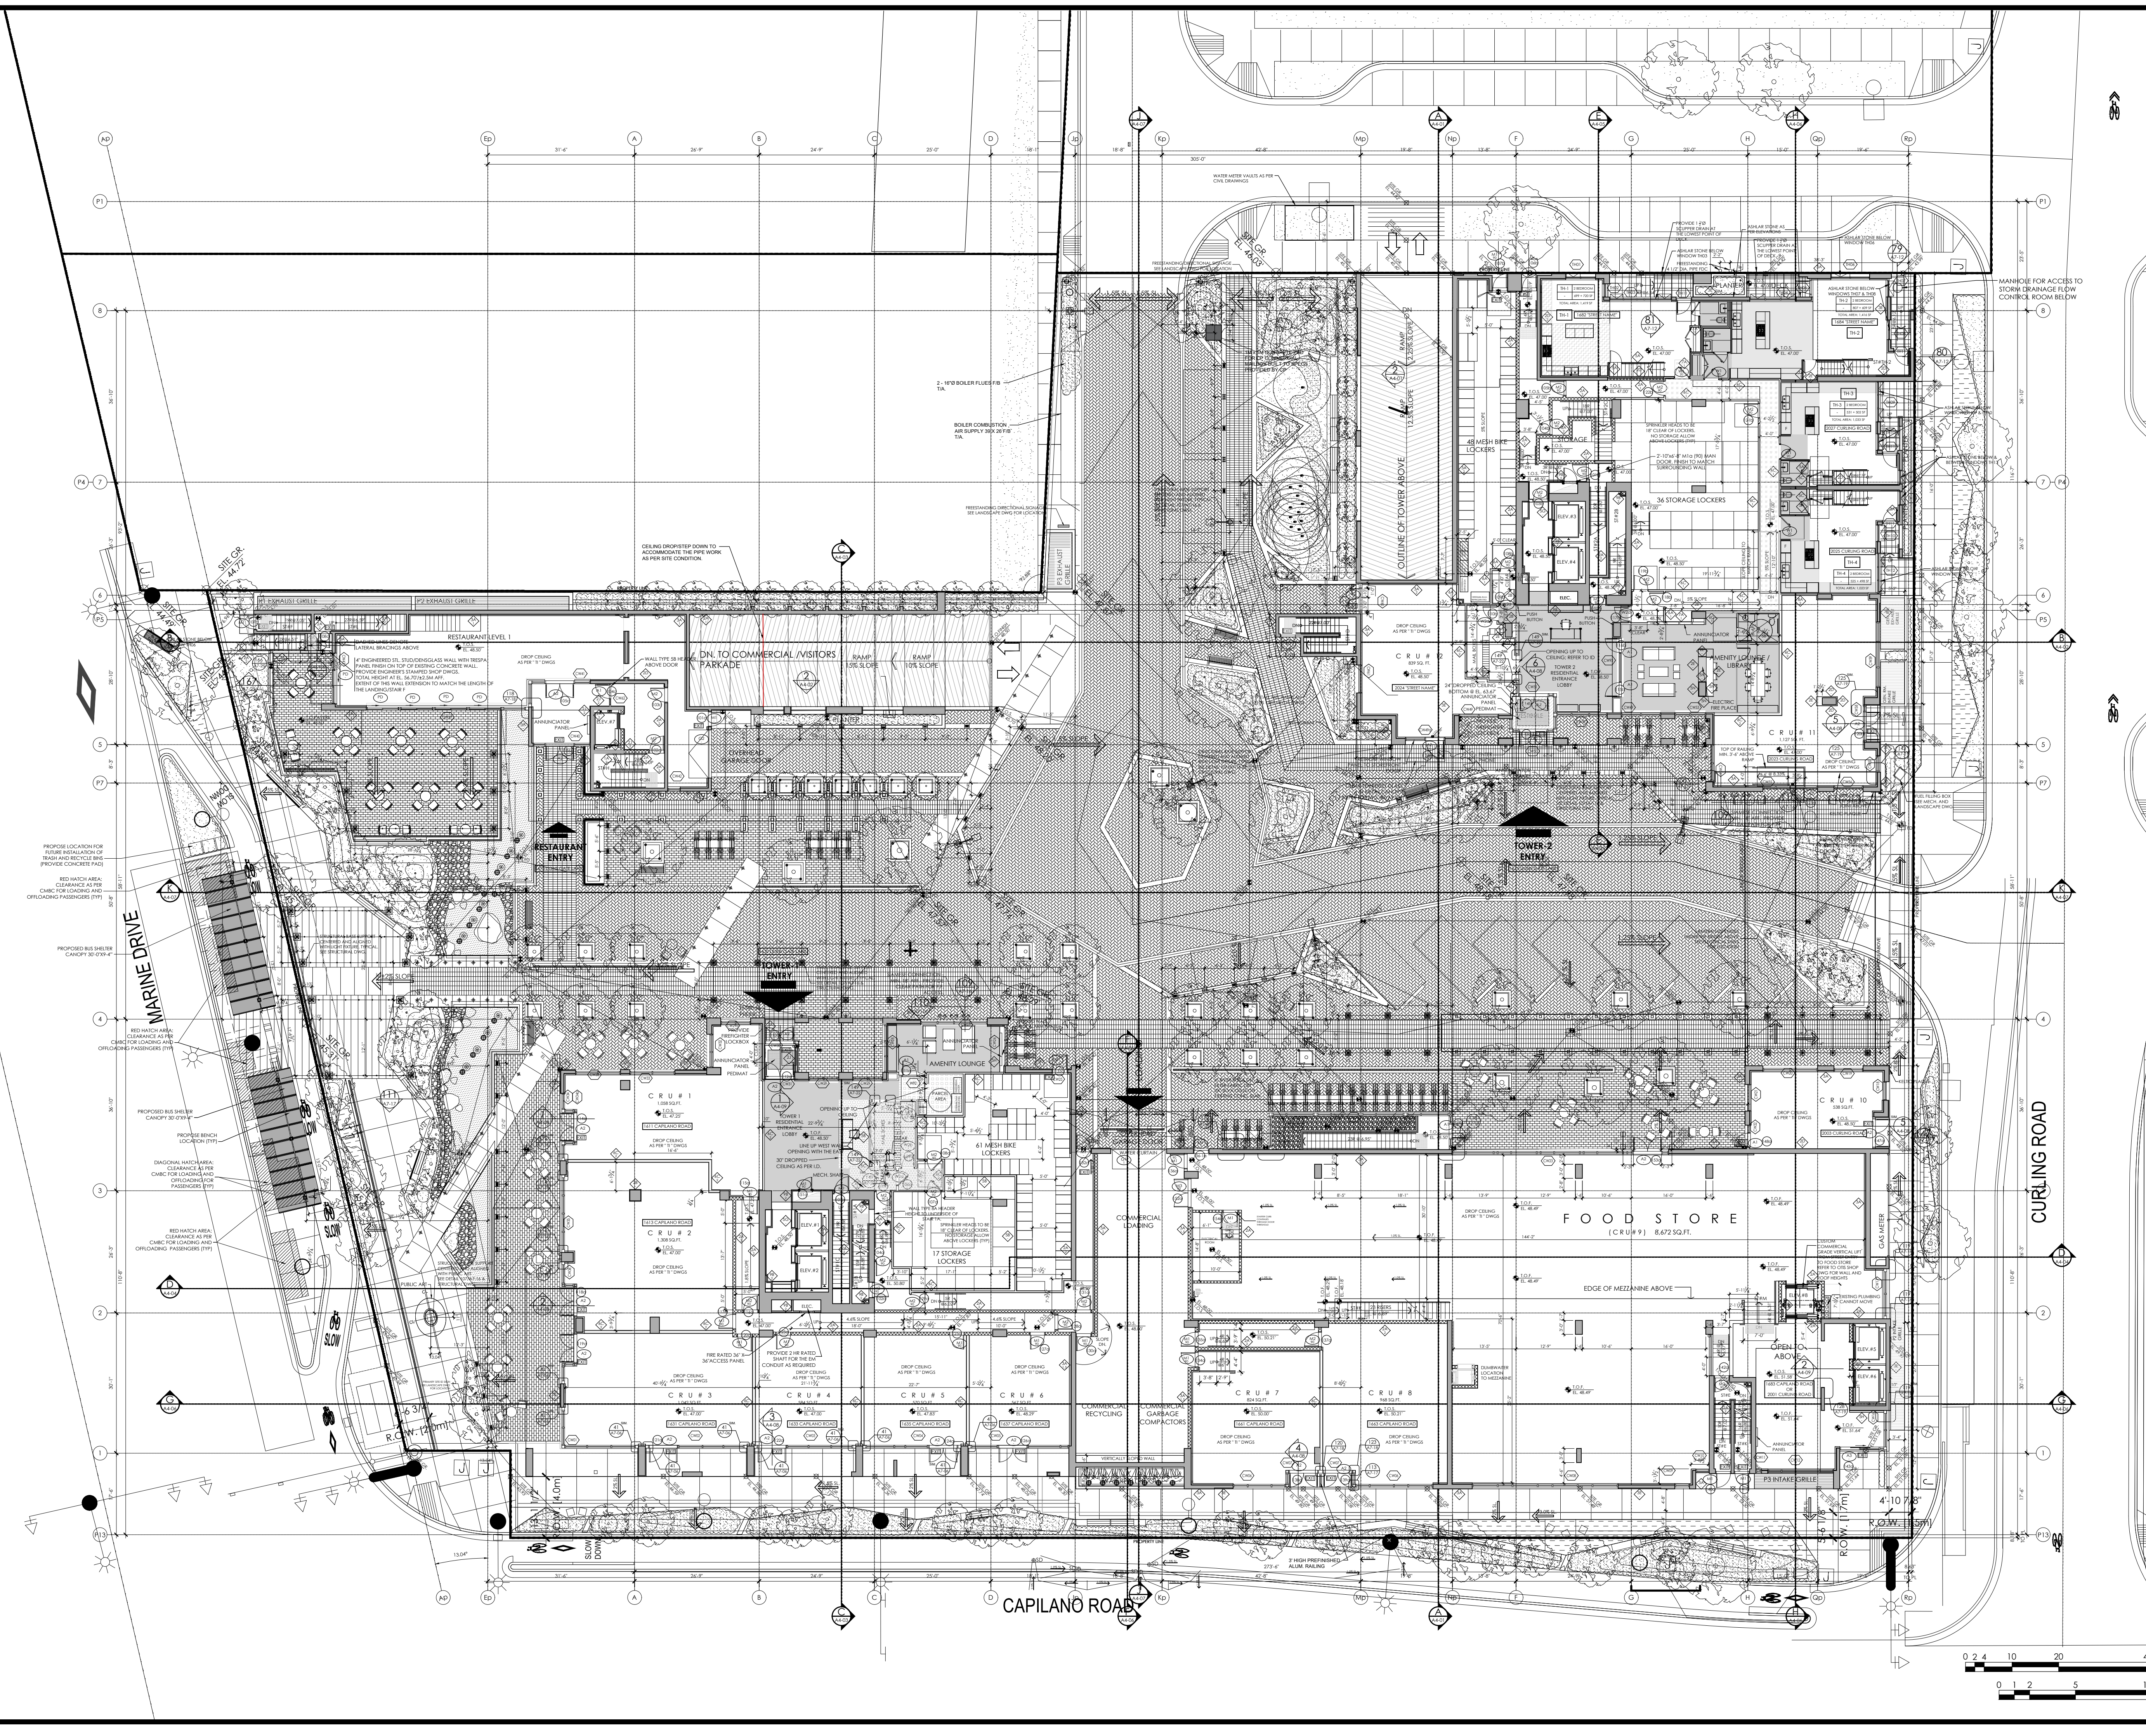

HA.12-16.PRINTSET; Updates from Brian 11.21.16-q2-04-floor plan-level 1-lower.dwg 2024-01-09 5:24:55 PM Andrew Cenner