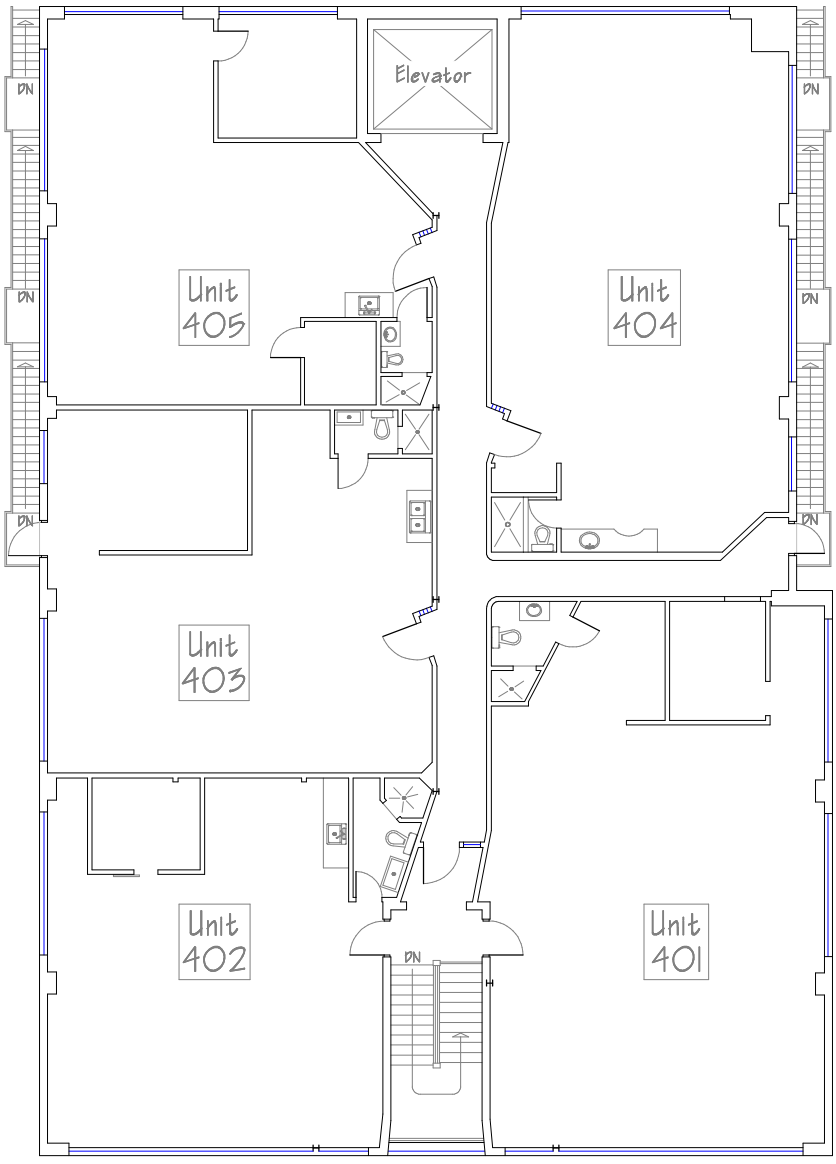


Richmond Street Frontage

0' 8' 16'

SCALE

Fourth Level
688 Richmond St West
Toronto, Ontario

As measured May 6, 2014

measured as built

(416) 465-4554

Scale 1 : 192.00