

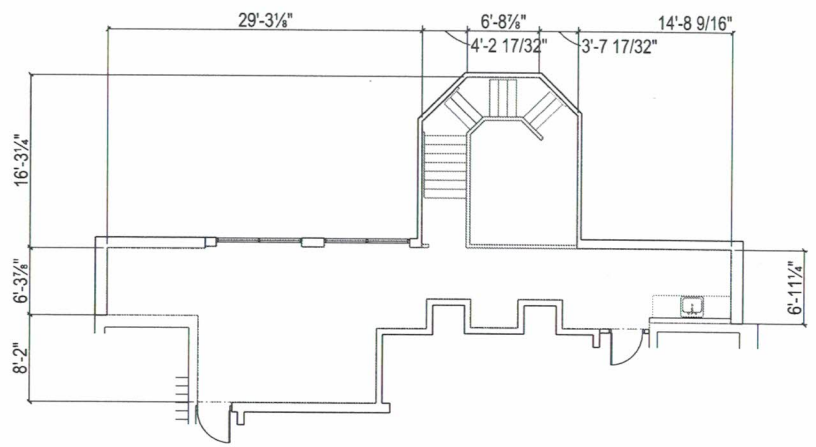


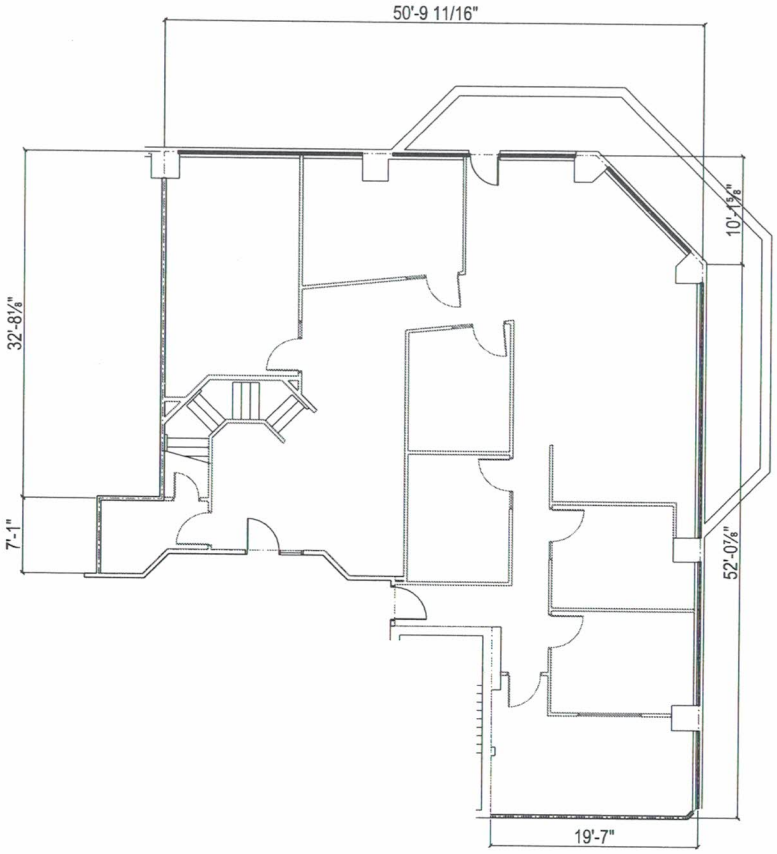

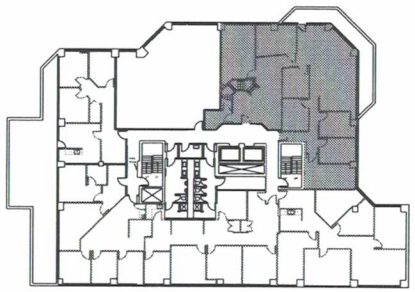

Certified Measurement Professional

SURVEYED BY: JS	SURVEY DATE: 2018-NOV	DRAWN BY: JS	DRAWN DATE: 2018-NOV-23	#500 Campana Place 609 - 14th Street NW Calgary, AB	4' 0' 2' 4' 8'	As Built MEASURING SERVICES asbuilt.ca +1-403-830-5591
FIFTH FLOOR AREA: 2,453 SQ FT		MEZZANINE AREA: 751 SQ FT				
OCCUPANT AREA: 3,204 SQ FT		RENTABLE AREA: 3,710 SQ FT		MEASUREMENT STANDARD ANSI/BOMA Z65.1-2017 METHOD A	SCALE: 1/8"=1'-0" (ARCH C)	