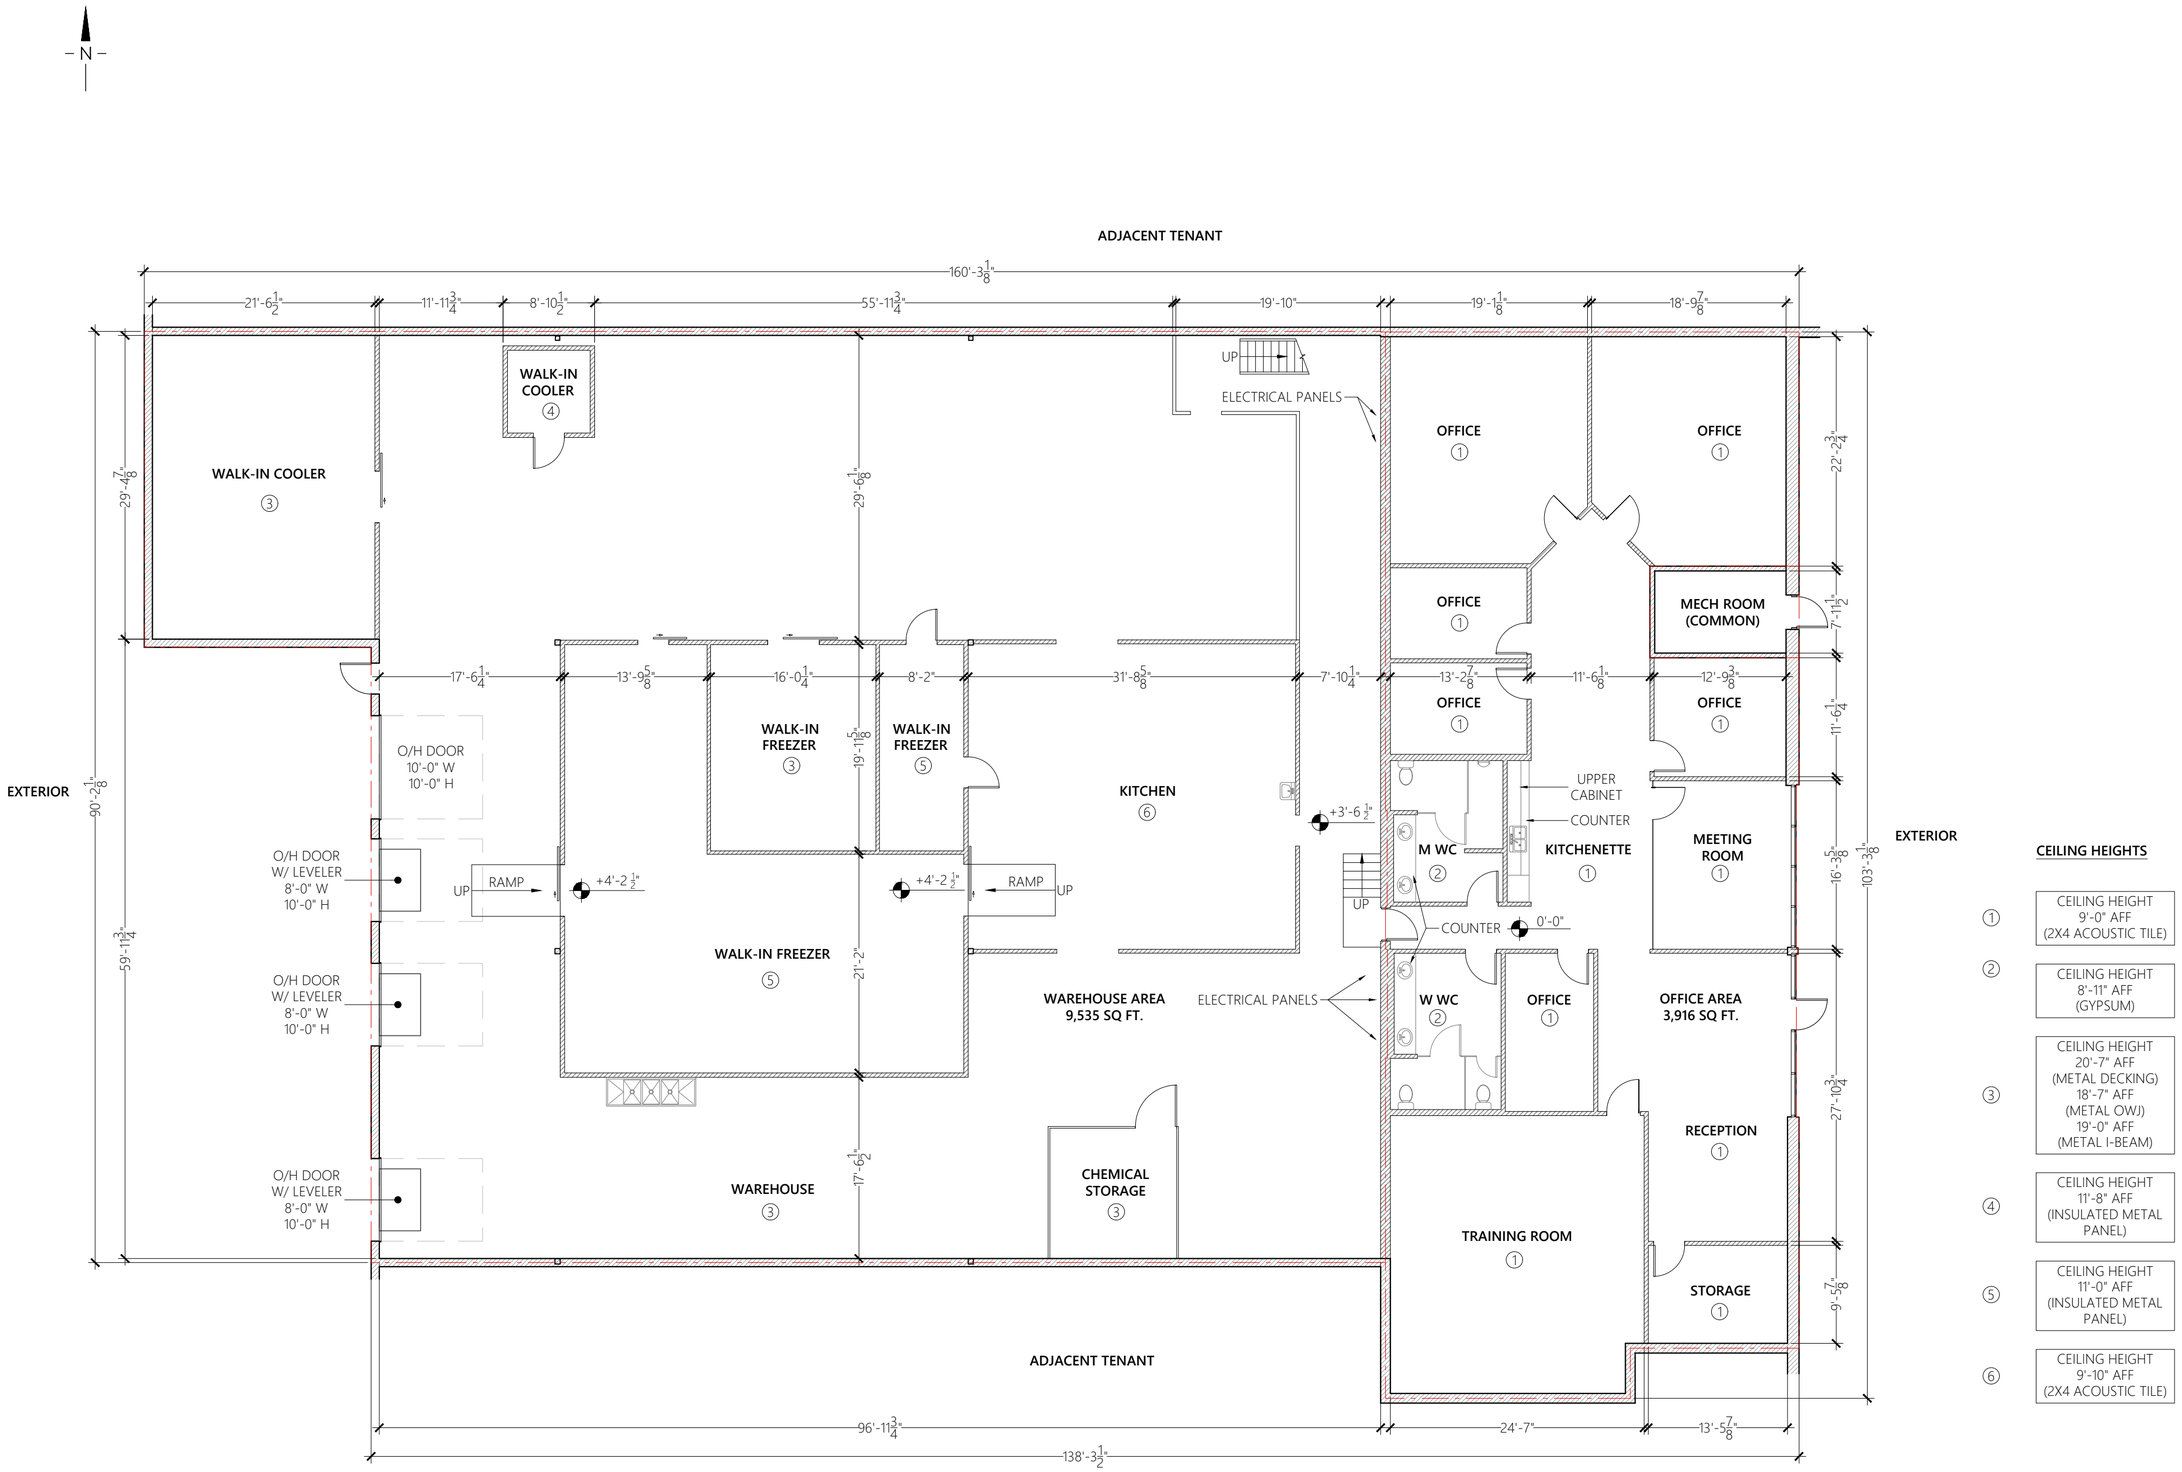

CEILING HEIGHTS

①	CEILING HEIGHT 9'-0" AFF (2X4 ACOUSTIC TILE)
②	CEILING HEIGHT 8'-11" AFF (GYPSUM)
③	CEILING HEIGHT 20'-7" AFF (METAL DECKING) 18'-7" AFF (METAL OWJ) 19'-0" AFF (METAL I-BEAM)
④	CEILING HEIGHT 11'-8" AFF (INSULATED METAL PANEL)
⑤	CEILING HEIGHT 11'-0" AFF (INSULATED METAL PANEL)
⑥	CEILING HEIGHT 9'-10" AFF (2X4 ACOUSTIC TILE)

1 MAIN LEVEL AREA SURVEY

3/32" = 1'-0"

MAIN LEVEL

3815
29 ST NE
CALGARY, AB

PREPARED FOR:

JERICKSON@DREAM.CA

MEASUREMENT STANDARD:
ANSI/BOMA Z65.2-2019

LAND USE:
I-G

OCCUPANT AREA:
13,451 SQ FT.

CERTIFICATE:

WE VISITED 29 ST NE, CALGARY, TENANT SPACE #3815 ON 12/02/2026 TO CONFIRM THE CONSTRUCTED AREA. MEASURED IN ACCORDANCE WITH THE ABOVE CITED STANDARD (MEASURED FROM THE OUTERMOST ARCHITECTURAL FINISH AT EXTERIOR WALLS EXCLUSIVE OF DECORATIVE PROJECTIONS, THE TENANT SIDE OF WALLS SEPARATING TENANTS FROM COMMON AREA OR "MAJOR VERTICAL PENETRATIONS", AND THE CENTRE OF ANY DEMISING WALLS), WE VERIFY THE "OCCUPANT AREA" OF THE PREMISES TO BE 13,451 SQUARE FEET.

JORDAN SASGES
PRINCIPAL-OPERATIONS

13/02/26
DATE

SURVEYED BY: CS

PREPARED BY: CB

DRAWING TITLE:
MAIN LEVEL AREA SURVEY

SURVEY DATE: 12/02/26

SHEET: AB-A02

PROJECT NUMBER: 5242

As Built MEASURING SERVICES
+1 (587) 374-0828 | info@asbuiltmeasuringservices.ca