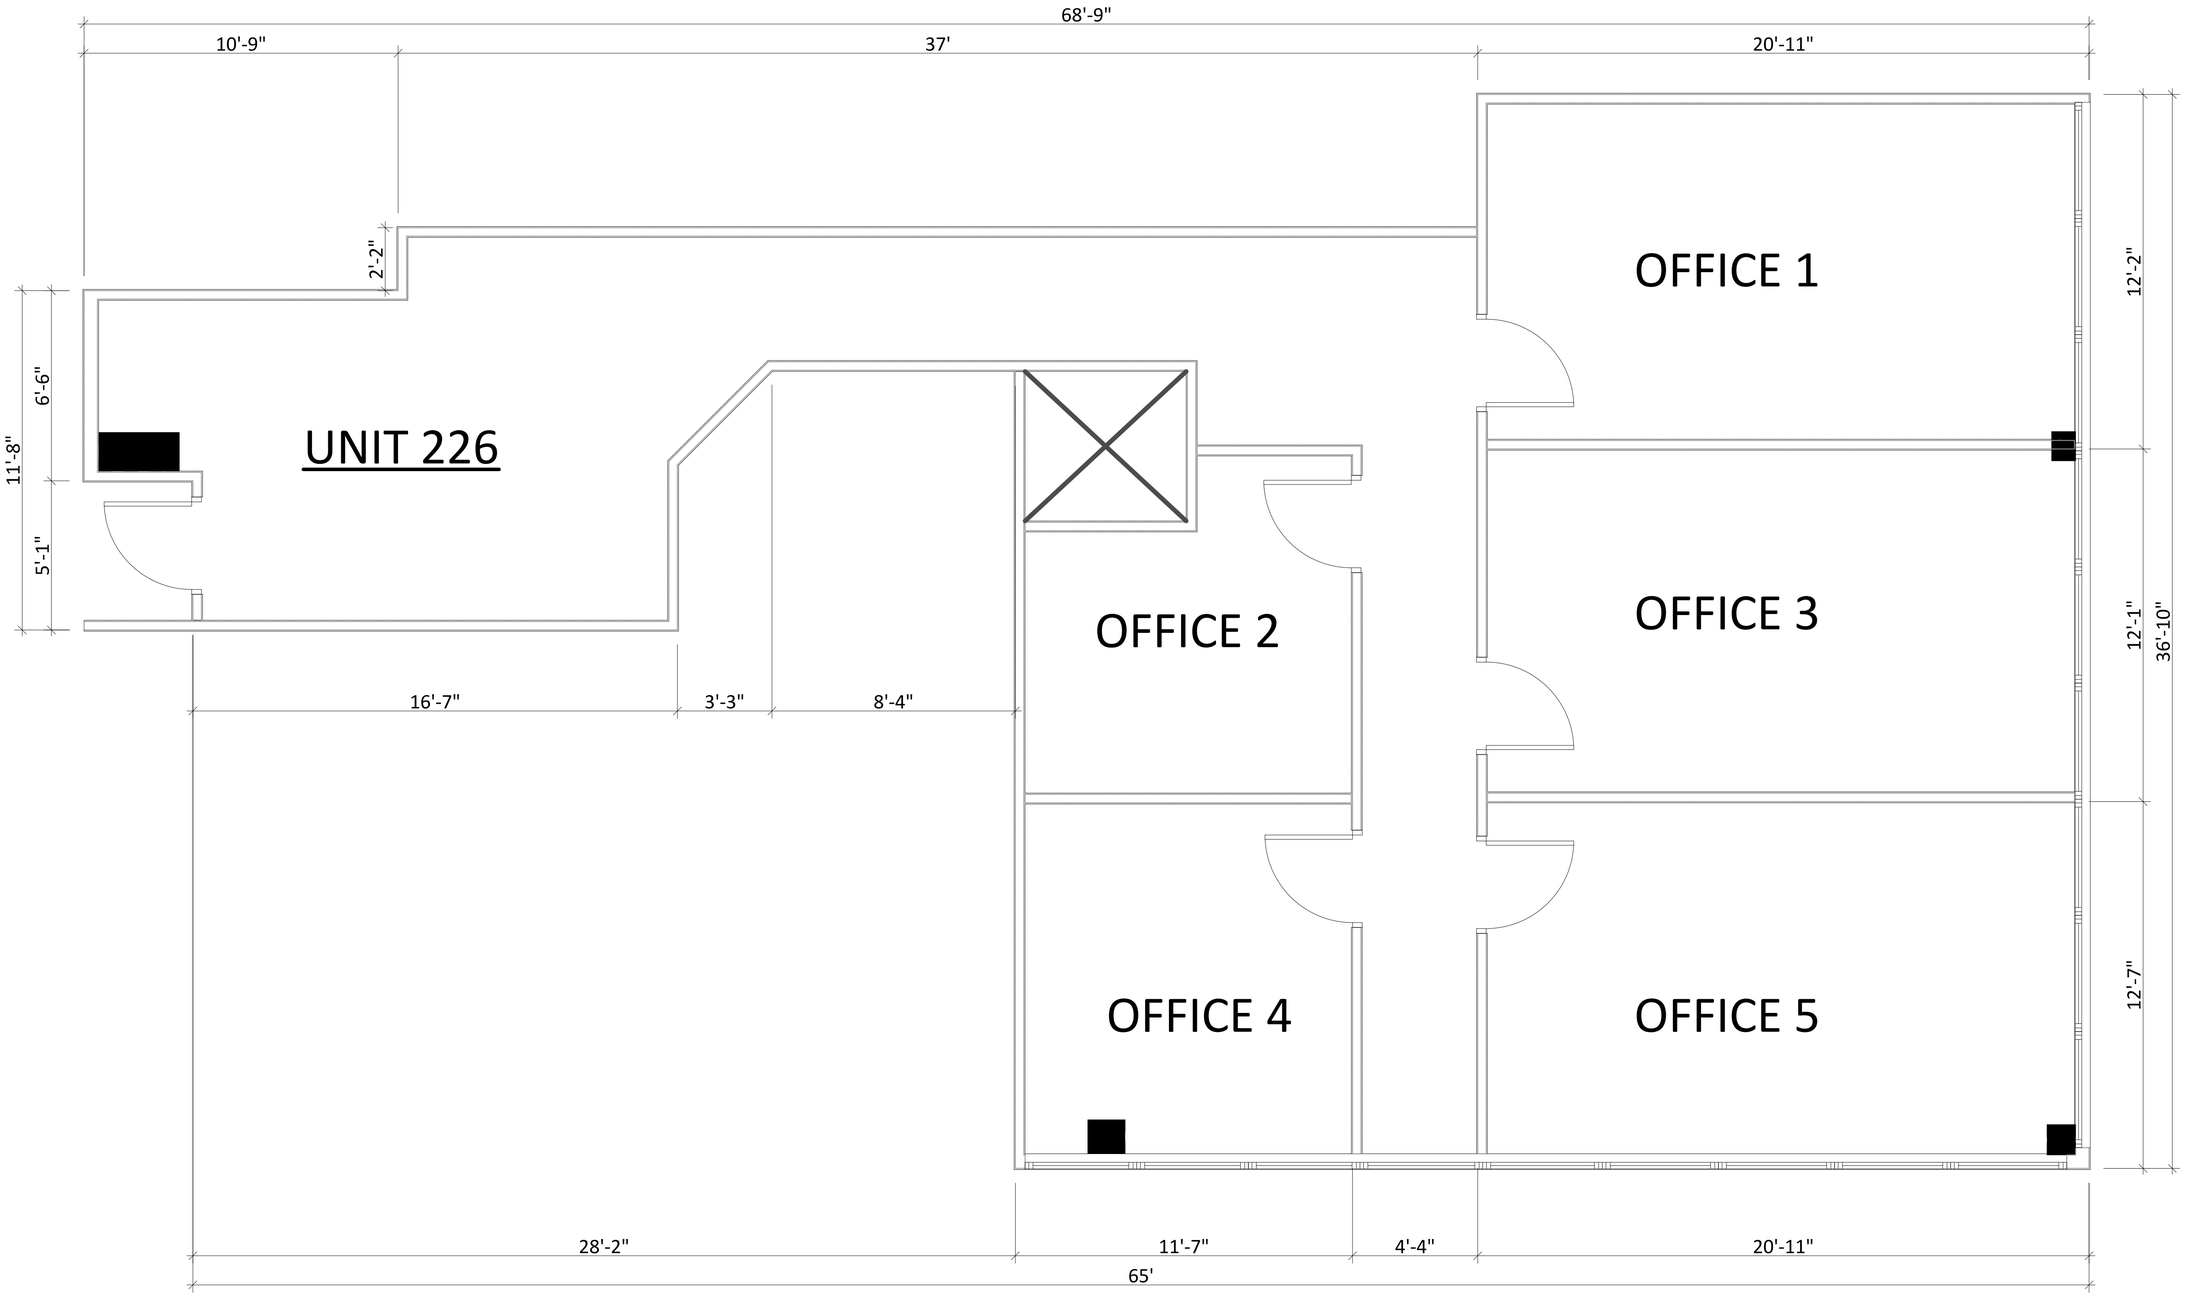

1
A1

UNIT 226 (1598 sf ft)

SCALE: 3/8" = 1'-0"

THE PLANS AND RELATED MATERIALS ARE PROTECTED BY COPYRIGHT AND ARE THE PROPERTY OF HLC HOMES REPRODUCTION OF THESE PLANS, EITHER IN WHOLE OR IN PART, INCLUDING ANY FORM AND/OR PREPARATION OF DERIVATIVE WORK, FOR ANY REASON WITHOUT PRIOR WRITTEN PERMISSION IS STRICTLY PROHIBITED.

THE PURCHASE OF A SET OF CONSTRUCTION DRAWINGS IN NO WAY TRANSFERS ANY COPYRIGHT OR OTHER OWNERSHIP INTEREST TO THE BUYER, EXCEPT FOR A LIMITED LICENSE TO USE THIS SET OF DRAWINGS FOR THE CONSTRUCTION OF ONE, AND ONLY ONE DWELLING.

DRAWINGS ARE NOT TO BE SCALED. ANY ERRORS, OMISSIONS OR DISCREPANCIES WITH THE DRAWINGS MUST BE REPORTED TO HLC HOMES PRIOR TO CONSTRUCTION. IF THESE ERRORS, OMISSIONS OR DISCREPANCIES ARE NOT REPORTED TO HLC HOMES PRIOR TO CONSTRUCTION THE BUILDER AND/OR OWNER ARE FULLY RESPONSIBLE.

ALL WORK IS PERFORMED TO COMPLY TO CURRENT ALBERTA BUILDING CODE, AND ALL OTHER AUTHORITIES HAVING JURISDICTION.

DRAWING

ISSUED FOR:	DATE: (D/M/Y)

REVISION:	DATE: (D/M/Y)
1.	
2.	
3.	
4.	

ENGINEER CONSULTANT

SURVEYOR CONSULTANT

As Built

CLIENT:

Maple Rise Investment Inc.

PROJECT NAME & ADDRESS:

4000 4th St SE (Building 200)
Calgary, AB

DRAWING TITLE:

PROJECT #:	
DATE:	March 13, 2026
SCALE:	AS SHOWN
DRAWN BY:	Y.L

DRAWING #:

A1

PLEASE RECYCLE THIS PLAN UPON COMPLETION OF THE PROPOSED PROJECT.